



Addendum #002
Invitation to Bid (ITB) 2443-2025
Athletics Maintenance Building No. 3 Re-Roof Project

Date: February 20, 2025

Solicitation: ITB 2443-2025 Athletics Maintenance Building No. 3 Re-Roof Project


Proposals Due: February 27, 2025, at 2:00 P.M. EST

Failure to file a protest within the time prescribed in Section 120.57(3), Florida Statutes, or failure to post the bond or other security required by law within the time allowed for filing a bond shall constitute a waiver of proceedings under Chapter 120, Florida Statutes.



Please be advised that the changes below are applicable to the original specifications of the above-referenced solicitation.

Change No. 1:

Replaces Exhibit B, Architectural Construction Documents and Specifications (See Attached)

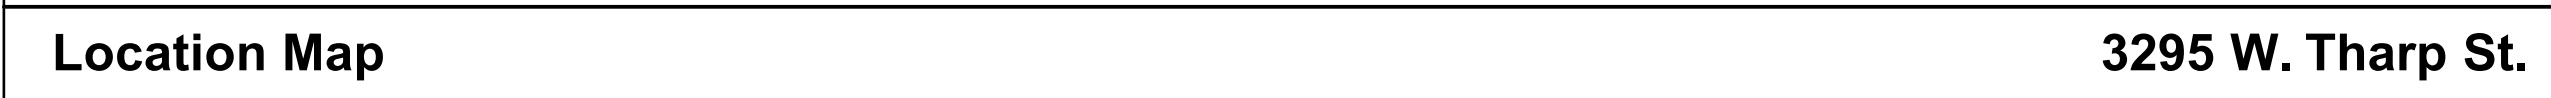

| PHASE: | DRAWN: | REVIEWED: | DATE: | ID: | REVISION: | DRAWN: | REVIEWED: | DATE: |
|-------------------------|--------|-------------|------------|-----|----------------|--------|-----------|----------|
| CONCEPT SCHEM DESIGN | | | | 1 | Addendum No. 2 | BB | R. Lewis | 2/7/2025 |
| AWAC CONSTRUCTION DOCS. | | | | | | | | |
| 90% CONSTRUCTION DOCS. | | | | | | | | |
| PERMIT DOCS | | | | | | | | |
| 100% CONSTRUCTION DOCS | BB | C. WHITLOCK | 10/25/2024 | | | | | |

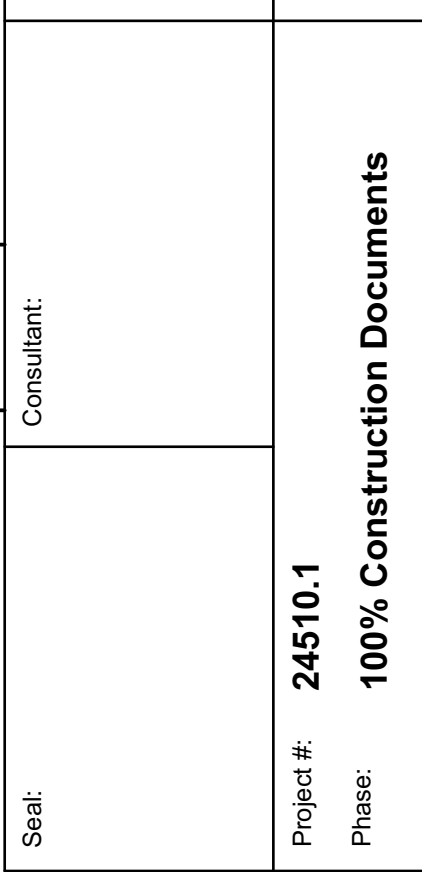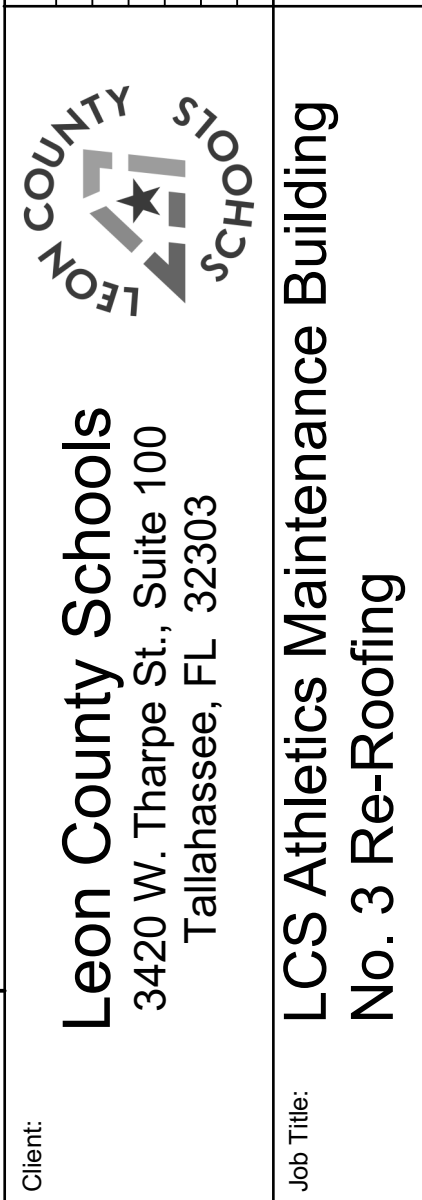

Architects Lewis + Whitlock
206 West Virginia St.
Tallahassee, Florida 32301
850.942.1718
www.think3d.net

Description:
**Index of Drawings,
Standard
Abbreviations and
General Notes**

Sheet No.:
G1.0

| | |
|--|--|
| DIVISION 11 - EQUIPMENT | |
| SECTION 116713 | |
| BOWLING ALLEY EQUIPMENT | |
| PART 1 GENERAL | |
| 1.01 SECTION INCLUDES | |
| A. Bowling Alley Equipment. | |
| 1.02 RELATED REQUIREMENTS | |
| A. Section 012300 - Alternates: Descriptions of items, administrative requirements. | |
| B. Section 013000 - Administrative Requirements: Submittal procedures, project meetings, progress schedules and documentation, reports, coordination. | |
| C. Section 014000 - Quality Requirements: Procedures for testing, inspection, mock-ups, reports, certificates; use of reference standards. | |
| D. Section 017800 - Closeout Submittals: Project record documents, operation and maintenance (O&M) data, warranties and bonds. | |
| 1.03 ADMINISTRATIVE REQUIREMENTS | |
| A. Preinstallation Meeting: Conduct a preinstallation meeting one week prior to the start of the work of this section; require attendance by all affected installers. | |
| B. Sequencing: Ensure that utility connections are achieved in an orderly and expeditious manner. | |
| 1.04 SUBMITTALS | |
| A. See Section 013000 - Administrative Requirements, for submittal procedures. | |
| B. Product Data: Provide manufacturer's technical information for all equipment to be provided, including details about materials, components, finishes and required utility connections.. | |
| C. Shop Drawings: Indicate required opening dimensions and tolerances, placement dimensions of equipment, and perimeter conditions of construction.. | |
| D. Samples: submit samples of all finish options for initial selection. | |
| E. Manufacturer's Qualification Statement. | |
| F. Installer's Qualification Statement. | |
| G. Maintenance Data: Provide maintenance data for all equipment.. | |
| H. Warranty Documentation: Submit manufacturer warranty and ensure that forms have been completed in Owner's name and registered with manufacturer. | |
| 1.05 QUALITY ASSURANCE | |
| A. Manufacturer Qualifications: Company specializing in manufacturing products specified in this section, with at least five years of documented experience. | |
| B. Installer Qualifications: Company specializing in performing work of the type specified and with at least five years of documented experience. | |
| 1.06 WARRANTY | |
| A. See Section 017800 - Closeout Submittals, for additional warranty requirements. | |
| B. Warranty period for equipment specified under Products section. | |
| PART 2 PRODUCTS | |
| 2.01 MANUFACTURERS | |
| A. Basis of Design: Brunswick Bowling Equipment. | |
| 1. Lanes (Brunswick Pro Lane Bowling Lane) Preferred lane surface. | |
| 2. A synthetic bowling lane which is 7/16" thick and is made from 100% solid phenolic laminate. The lane will feature a maple image and will include board lines, USBC Certified down-lane markings that provide additional targets serves as an instructional aid for bowlers. Lanes will have a complete edge-to-edge glow effect on lane and approach for use during "glow bowling" events under black light. | |
| a. Alternating light/dark board design, with every fifth board being highlighted to provide target zones to aid bowlers. | |
| b. Down-lane markings to help bowlers develop precise break points and improve scores. | |
| c. Integrated foul line with no seam for better stability and durability. | |
| d. Anti-skid pin deck to reduce sliding pins and out-of-range trouble calls, and will have "scribed" pin spots. | |
| e. 60"-wide, textured approach panels for improved, more consistent sliding conditions | |
| f. The bowling lane will have a written lifetime warranty against delamination backed up by the manufacturer. | |
| g. The bowling lane will have the ability to have custom glow ink images, logos, or printed images installed to match center brand purposes. | |
| h. The bowling lane will have the ability to select from more than 100 custom colored lane option. | |
| i. The lane will have a written 5-year warranty against defects. | |
| j. The lane will have a written one-year warranty on labor backed up by the manufacturer when installed by the manufacturer. | |
| B. Bowling Lane Foundation. | |
| 1. Bowling lane underlayment will be made from "laminated strand lumber". LSL is a structural grade composite lumber manufactured from strands of wood whose grain has been glued and pressed in parallel orientation. LSL is most often used in structural applications such as building truss systems, load bearing supports and framing. LSL provides a much more robust base for bowling lanes. | |
| 2. I-joist-supported foundation to provide outstanding dimensional stability and minimize floor movement. | |
| C. Ball Return System | |
| 1. Fiberglass hood to maximize durability and resistance to bowler/ball damage. | |
| 2. Safety system shall use 8 infrared light beams across the exit/opening of the ball lift and shut down the ball lift if a foreign object enters the opening or the ball rack is full. The ball lift should restart automatically when the foreign object is removed with no staff intervention necessary. | |
| 3. Compatible with the Framework ball lift system. | |
| 4. Holds up to 12 balls each on the main rack. Optional racks are available to further expand capacity. Eight additional balls can be stored on a separate lower rack that is 1-1/2" off the lane surface for easy cleaning. | |
| 5. The control box must be above the lane surface for access. | |
| 6. The motor shall be located under the lane surface and out of the reach of bowlers and accessible through a trap door in the approach. | |
| 7. Ball rack shall be ergonomically placed at 15-1/2" to accommodate all ages of bowlers. | |
| D. Automatic Bumper Rails | |
| 1. Curved front rails to improve durability by reducing the force of ball impact. | |
| 2. 30 uprights per side (60 per lane) to reduce impact forces and improve durability. | |
| 3. Heavy-duty construction, including metal gears within the motor assembly, metal uprights, actuator arm, and rail. | |
| 4. Motorized rails automatically raise or lower for each bowler. | |
| 5. Integrated safety system provides continuous bowler protection in automatic mode. | |
| 6. Automatically detects foreign objects and raises itself in case a person crosses the foul line and gets their foot caught under the rail. | |
| 7. System should not be lowered via gravity to prevent a user from getting their foot stuck under the rail. | |
| E. Lightwork Pindeck Lighting | |
| 1. A Pindeck Lighting solution which can change the look and feel of your center at any time, creating a new, exciting experience for bowlers and observers alike; including the following: | |
| a. System with dozens of preset, multi-color patterns and sequences. | |
| b. One fixture per lane including over 250 LED's in nine programmable clusters that can display every color of the spectrum. | |
| c. Integrated microphones within each fixture which can sync lights to music. | |
| d. Only one independent power source required for every 12-14 lanes. | |
| e. DMX controller provides easy operation and customization of patterns and sequences. | |
| F. Scoring and Management System (Sync) | |
| 1. Management System: | |
| a. Hardware: | |
| 1) Back office server must be a commercial-grade server with dual Raid1 SSD hard drives and dual power supply for increased system reliability. | |
| 2) Back office server must be Windows Server 2016 or later | |
| 3) Client computer with Windows 10 | |
| 4) All Clients and Servers should have 3-year warranties provided by Dell® | |
| 5) System must have optional 7" or 10" mobile tablet POS workstation with 16-hour battery life, shoulder sling, Windows 10 IoT, integrated point of sale functionality, and optional credit card reader. | |
| b. System must have optional All-in-One Clients with integrated receipt printers, swipe cards, and pole displays. | |
| B. Bowling Lane Control | |
| 1) Scoresheet selection | |
| 2) Theme selection | |
| 3) Video control | |
| 4) Advertising and Messages | |
| 5) Lane transfers | |
| 6) Bowler name entry, email entry, and score corrections | |
| 7) Graphics controls | |
| 8) Integrated Intercom | |
| C. Bumper Control by bowler | |
| 1) Bowling by Game | |
| 2) Bowling by Time | |
| 3) GS-X Pinsetter control including pin(s) selection | |
| d. Guest Management | |
| 1) Guest Management view panel to easily track and move parties throughout the center. | |
| 2) Ability to assign to bowling and non-bowling resources. | |
| 3) Mobile waitlist texting management service with ability to text guests, estimate wait times, and receive guest confirmations. | |
| 4) Ability for guests to enter their bowling names, email address, and other information on their online reservation or waitlist text and have this information automatically sent to the management, scoring system, and CRM system. | |
| 5) Advanced Reservations. | |
| a) Ability to reserve multiple resources, including lanes, party rooms, tables, etc. on a single reservation. | |
| 7) Ability to email invoices and reservation confirmations | |
| 8) Ability to attach products to reservations to save time when the reservation is activated. | |
| 9) Ability to accept individual bowler names and email addresses and assign this information to the lane when the reservation is activated. | |
| e. Restaurant-Grade Point of Sale | |
| 1) User Security with employee roles and multiple access/manager override options. | |
| 2) Flexible tabbed transactions, including split/merge/move tabs, items, and transactions. | |

- Food/Beverage functionality including food & beverage modifiers, remote order printing capability, and hold/fire functionality.
- Unlimited products and product "packages", including ability customize logos, view panels, button size, and color.
- Ability to interface products and product "packages" with web-based coupons.
- Integrated 2D QR reader for coupon scanning and redemption.
- Sales related to coupons redeemed should be tracked and reported on Pre-paid and Post-Paid transaction.
- Restaurant/Table functionality, including ability to associate tabs with tables.
- Quick-access buttons to assist wait staff, including ingredient list, price preview, and help text.
- Table management and rental controls.
- Account Tracking.
- Ingredient tracking for export to common inventory management programs, including Yellow Dog software.
- Interface to Chef-Tab Kitchen Display Systems.
- Use payment card solution that keeps the scoring and management system out of scope for PA-DSS to support cost effective PCI compliance.
- Journal Log feature to allow for historical reporting.
- Back Office
 - Customize POS and lane status view panels by role.
 - Employee memo features with manager tracking.
 - Multi-zone capabilities, along with custom resource control (billiards, restaurant tables, darts, party room, etc.).
 - System audit to identify potential theft issues.
 - Automated System Health to identify the status of scoring, management, and POS software and hardware.
 - Advanced reporting with XML- and CSV-based exports and ability import/export/merge reports.
 - Interface to MICROS POS system.
 - Interface to Azbar, and Berg beverage control systems.
 - Real-time sales reporting interface for YellowDog Inventory Management System and other 3rd parties.
 - Interfaces with Embed®, InterCard®, and Sacoa® amusement game card systems.
 - Automatically download marketing content from cloud-based marketing systems.
 - Automatically download software updates, and give administrators the ability to push software updates to the entire system from the Management software.
 - Complete labor management system with HotSchedules integration, labor forecasting, and virtual and physical timeclock solutions.
- Scoring
 - Exclusive scoring system used by the USBC to run Open and Women's Championships through 2024.
 - Hardware
 - Scoring resolution should be true 1920x1080p HD.
 - Overhead electronics should be Windows operating system.
 - Bowler consoles available in stand-alone mounting format or mountable on Center Stage, Framework, and Striking Line furniture.
 - Bowler consoles to be no greater than 10.1" diagonal to minimize total footprint in the bowler's area.
 - Tablet bowler consoles use commercial-grade LED 50,000-hour backlight, capacitive touch technology, and offers standby capabilities to extend the life of the tablet.
 - Overhead monitors must have 32", 43", 49", and 55" LED widescreen monitors with 3-year warranties.
 - Technology
 - Product utilizes distributed scoring architecture which provides:
 - The ability for each bowler and each team to automatically track up to two other unique bowlers and teams.
 - The ability to automatically broadcast player events across a range of lanes when issued for groups.
 - The ability to continue bowling on lanes even if the scoring computer or tablet for the lanes fails.
 - The ability to schedule and display unique advertising simultaneously on individual lane or groups of lanes scoring monitors, both in-game and when the lane is off.
 - Scoring software cannot be designed using discontinued software programming languages such as Visual Basic.
 - Scoring computers will automatically "back-up" data every ball to the center management computer system. Center management computer will have the ability to restore/recovery capability of this data to the scoring computers.
 - Scoring system will provide the ability to set any pin combination on-demand from both the scoring console and the front desk computer when installed with Brunswick GS-X® pinsetters, providing bowlers with the easy capability to play games, practice spares and providing center personnel the ability to set spares or re-spot pins.
 - Scoring system will not have the need for a scoring camera and/or associated parts when being used with Brunswick GS-X® pinsetters. Automatic scoring will be done via a direct interface between the new scoring system and the GS-X pinsetters. The scoring computer software, bowler consoles, and other peripherals software and firmware can be updated automatically from a single location using the management system.
 - Interface to 3rd parties such as Magix Lanes so that those products may integrate bowling events (strikes, spares, etc.) into their guest experiences.
 - Bowling Games
 - Games for open and group event bowling, including pinpix, Rival Rumble, Kapow, The Buzz, Stat King, and numerous other 10-pin themes, including the ability to automatically broadcast player events across a range of lanes when issued for groups.
 - Games for birthdays, including Angry Birds Bowling, EZ Bowling, and Creature Feature that are simple, easy to understand, and fun to play.
 - Games that allow bowlers to submit and use their own photo from a mobile device.
 - Games for competitive bowlers, including The League, HORSE, myShot, and Best Frame.
 - Game that allows each bowler and each team to automatically track up to two other unique bowlers and teams.
 - Games that allow bowlers to select pin combinations that the group of bowlers competes against. This includes HORSE, which is to the street basketball game, and myShot, which allows bowlers to select a pin shot pattern and track their performance statistics.
 - Must offer a selection of games that utilizes the on-demand pinsetting capabilities of the GS- and StringPin pinsetters.
 - Automatically send scoresheets to bowlers via email, with ability for bowlers to share to Facebook and Twitter from their mobile device.
 - Web site for bowlers to track their stats, scores, and receive special offers.
 - Customer Service
 - Ability to upload menus and/or create custom images that promote center specials and menu items. The custom image should include a Staff Call To Action button. The Staff Call To Action is a customizable special button on the bowler console that notifies staff when a guest selects a given button.
 - VoIP intercom for tablet bowler console, with the ability to customize specific text based service messages.
 - 7" or 10" mobile POS tablet with tab management and remote order printer integration, with hardware having a 16-hour battery life.
 - Marketing and Loyalty/Rewards Integration
 - Must display advertisements in-game on the overhead monitor, bowler console, and digital signage platforms, with content generated using the cloud-based marketing and media management system.
 - Allow the bowler to sign in at the lane to track scores, stats, and get their scoresheet emailed to them at the end of the game.
 - Allow the bowler to provide email at the tablet console that will result in an email containing their scoresheet, offers, and ability to share to personal Facebook or Twitter accounts.
 - System must have a mobile-friendly web site that allows bowlers to track their stats, scores, and offers earned by visiting the center.
 - System must be able to track spending associated by bowler when redeeming unique offers/coupons.
 - Marketing
 - Scoring and Management system should include a fully integrated cloud-based Customer Relationship Management (CRM) system with the ability to create, schedule, and distribute marketing campaigns over multiple channels, including in-center scoring and POS systems, digital signage, Facebook, Twitter, email, and the center's web site from a single web-based interface.
 - Ability to schedule campaigns and marketing channels by day, time, location, and lane.
 - More than 45 pre-built marketing campaigns.
 - Campaign Builder – design marketing campaigns in as few as five clicks.
 - Media Manager – more than 200 marketing images.
 - Automatically send league recaps to bowlers.
 - Automatically collect and send scoresheet, reservation invoice, and receipts via email provided at the tablet bowler console, front desk, or through online reservation.
 - Ability to manage marketing content (images, videos, ads) through a web-based application. Application should provide the ability to tag, edit, and import/export media.
 - Ability to manage marketing for multiple centers from a single account.
 - Ability to create and send personalized offers to bowlers. Offers shall be scanned via QR code scanner at the POS system and all revenue from offer tracked in the CRM system along with redemption statistics.
 - Membership program that gives bowlers the ability to track their scores, stats, and personalized offers through a mobile-friendly web site.
 - Bowlers should be able to share emailed scoresheets to bowler's Facebook and Twitter accounts.
 - System should send users monthly summaries of Sync marketing activities, including a marketing score, metrics, and system notifications.
 - Digital Signage system should be controlled by centralized CRM system, including the ability to create and schedule content to be displayed. This can include the automatic display of scoring lane assignments, waitlists, and marketing content using predefined templates that accept videos and imagery.
 - All intellectual property for the new scoring system will be owned by the seller and licensed directly by seller to purchaser.
 - Freefall Pinsetter
 - The pinsetter, after the initial bowling ball is rolled, will automatically lift any standing pins and sweep all fallen pins from the pin deck. It then will automatically reset the standing pins and return the bowling ball to the bowler. After the second ball is thrown (or if all pins are knocked down on the initial first ball) the new pinsetter will automatically set 10 news pins for the bowler to begin a new delivery frame. The new pinsetter is supported over the pin deck by the kickbacks and will consist of 10 major subassemblies as follows:
 - Elevator – removes the bowling pins from the Transport Band sub-assembly for deposit into the Distributor sub-assembly.
 - Transport Band – moves fallen pins from the pin deck and deposits them to the Elevator.
 - Ball Cushion/Pit Curtain – absorbs impact of the bowling ball and pins.
 - Ball Accelerator – returns bowling ball to the bowler.
 - Sweep Wagon – sweeps all fallen pins from the pin deck.
 - Setting Table – Resets and Sets pins to the pin deck and provides pin count to Automatic Scorer.
 - Drive Frame – holds motors, gears and pulleys to manage all mechanical sub-assemblies.
 - Main Frame – supports the new machine on the kickbacks.
 - Distributor – moves pins from the Elevator to the Setting Table.
 - Electronics – provides programmable controller and machine intelligence.
 - In addition to performing all basic requirements to meet bowler and United States Bowling Congress (USBC) specifications, the new pinsetter will possess the following capabilities:
 - Will be able to automatically correct errors that occur if a pin falls before or after spotting.
 - Will have ability to remember and reset the last pin combination automatically.
 - Will not require a pinsetter cycle when the initial ball is delivered in the channel or just the 7/10 pins are knocked down.
 - Will be able to automatically correct bowler fouls and reset a full set of pins.

- Will be electronically triggered by a bowling ball passing an electronic photocell.
 - Will be able to conduct self-diagnostics in all different pinsetter modes.
 - Will provide electronic codes displayed so the pinsetter mechanic can diagnose errors and provide corrective action.
 - Will have ability to set individual pins on demand dependent on the Automatic Scorer Involved.
- The mechanical and electrical specifications of the new pinsetter will be:
 - Dimensions of 126" long, 66" wide and 76" high and weighs 1,800 pounds (2,000 pound shipping weight).
 - Will be powered by four (4) each 3 phase motors:
 - Distributor/Elevator/Transport Band motor – ½ horsepower.
 - Setting Table motor – ½ horsepower.
 - Sweep motor – ¼ horsepower.
 - Ball Accelerator motor – ½ horsepower (shared between 2 pinsetters).
 - Motors will be powered by 3 phase – 208 VAC, 220 VAC or 380 VAC with motor movements controlled by the new pinsetter electronics.
 - The ball return exit will be located on the side of the new pinsetter.
 - After first ball delivery the new pinsetter will be capable of picking up a pin that has moved 9 inches in any direction.
 - The written warranty associated with the new pinsetter will be:
 - Two (2) years mechanical parts and materials.
 - One (1) year on wear items such as belts, chains, etc.
 - One (1) year electrical parts.
 - Ninety (90) days labor.
 - All warranties reflect installation by manufacturer.
 - Machine should report error codes, machine states, and diagnostics to pinsetter controller and Automatic Scorer.
 - Lane Machine
 - Direct-to-lane conditioning system with 39 individual injectors to remove the variation that comes with transfer system machines.
 - Six-button Graphical User Interface to simplify ease of use and programming.
 - V-shaped squeegee cleaning system.
 - Option of running on AC or two different types of battery power.
 - Two (2) year warranty on the machine.
 - Substitutions: See Section 016000 - Product Requirements.

PART 3 EXECUTION

3.01 EXAMINATION

- Verification of Conditions: Verify that building components are acceptable for installation of bowling equipment..

3.02 INSTALLATION

- Install in accordance with manufacturer's instructions.

3.03 FIELD QUALITY CONTROL

- See Section 014000 - Quality Requirements, for additional requirements.
- Provide manufacturer's field representative to inspect equipment installation for conformance with manufacturer's standards..

3.04 SYSTEM STARTUP

- Provide manufacturer's field representative to perform systems startup.
- Prepare and start equipment and systems in accordance with manufacturers' instructions and recommendations.

3.05 ADJUSTING

- Adjust equipment for smooth operation.

3.06 CLOSEOUT ACTIVITIES

- Demonstration: Demonstrate operation of system to Owner's personnel.
 - Use operation and maintenance data as reference during demonstration.
 - Conduct walking tour of project.
 - Briefly describe function, operation, and maintenance of each component.
- Training: Train Owner's personnel on operation and maintenance of system.
 - Use operation and maintenance manual as training reference, supplemented with additional training materials as required.
 - Provide minimum of one day of training.
 - Instructor: Manufacturer's training personnel.
 - Location: At project site.

3.07 PROTECTION

- Protect installed flooring and equipment from subsequent construction operations.
- Do not permit traffic over unprotected floor surface.

END OF SECTION 116713
DIVISION 01 - GENERAL REQUIREMENTS
SECTION 011000
SUMMARY

PART 1 GENERAL

1.01 PROJECT

- Project Name: LCS Athletics Maintenance Building No. 3 Re-Roof
- Owner's Name: Leon County Schools.
- Architect's Name: Architects Lewis + Whitlock, PA.
- The project scope includes demolition and replacement of existing translucent roof panels. As well as adding retrofit standing seam roof with insulation above existing metal roof and replacing existing gutter and downspout system.

1.02 CONTRACT DESCRIPTION

- Contract Type: A single prime contract based on the Cost of the Work plus a fee as described in Document 005000 - Contracting Forms and Supplements.

1.03 OWNER OCCUPANCY

- Owner intends to continue to occupy adjacent portions of the existing building during the entire construction period.
- Owner intends to occupy the Project upon Substantial Completion.
- Cooperate with Owner to minimize conflict and to facilitate Owner's operations.
- Schedule the Work to accommodate Owner occupancy.

1.04 CONTRACTOR USE OF SITE AND PREMISES

- Construction Operations: Limited to areas noted on Drawings.
 - Locate and conduct construction activities in ways that will limit disturbance to site.
- Provide access to and from site as required by law and by Owner:
 - Emergency Building Exit During Construction: Keep all exits required by code open during construction period; provide temporary exit signs if exit routes are temporarily altered.
 - Do not obstruct roadways, sidewalks, or other public ways without permit.
- Utility Outages and Shutdown:
 - Do not disrupt or shut down life safety systems, including but not limited to fire sprinklers and fire alarm system, without 7 days notice to Owner and authorities having jurisdiction.
 - Prevent accidental disruption of utility services to other facilities.

1.05 WORK SEQUENCE

- Coordinate construction schedule and operations with Owner.

PART 2 PRODUCTS - NOT USED

PART 3 EXECUTION - NOT USED

END OF SECTION 011000
SECTION 012500
SUBSTITUTION PROCEDURES

PART 1 GENERAL

1.01 SECTION INCLUDES

- Procedural requirements for proposed substitutions.

1.02 RELATED REQUIREMENTS

- Section 002113 - Instructions to Bidders: Restrictions on timing of substitution requests.
- Section 004325 - Substitution Request Form - During Procurement: Required form for substitution requests made prior to award of contract (During procurement).
- Section 006325 - Substitution Request Form - During Construction: Required form for substitution requests made after award of contract (During construction).
- Section 013000 - Administrative Requirements: Submittal procedures, coordination.
- Section 016000 - Product Requirements: Fundamental product requirements, product options, delivery, storage, and handling.

1.03 DEFINITIONS

- Substitutions: Changes from Contract Documents requirements proposed by Contractor to materials, products, assemblies, and equipment.
 - Substitutions for Cause: Proposed due to changed Project circumstances beyond Contractor's control.
 - Substitutions for Convenience: Proposed due to possibility of offering substantial advantage to the Project.
 - Substitution requests offering advantages solely to the Contractor will not be considered.
- Substitutions: See General Conditions for definition.

PART 2 PRODUCTS - NOT USED

PART 3 EXECUTION

3.01 GENERAL REQUIREMENTS

| PHASE: | DRAWN: | REVIEWED: | DATE: | ID: | REVISION: | DATE: | DRAWN: | REVIEWED: | DATE: | C. WHITLOCK | 10/25/2024 |
|--|--------|-----------|-------|-----|-----------|-------|--------|-----------|-------|-------------|--|
| CONCEPT SCHEM DESIGN | | | | | | | | | | | |
| ADVANCED SCHEM DESIGN | | | | | | | | | | | |
| 50% CONSTRUCTION DOCS | | | | | | | | | | | |
| 80% CONSTRUCTION DOCS | | | | | | | | | | | |
| PERMIT DOCS | | | | | | | | | | | |
| 100% CONSTRUCTION DOCS | | | | | | | | | | | |
| THESE DRAWINGS AND RENDERINGS ARE INSTRUMENTS OF SERVICE. THE DRAWINGS AND ASSOCIATED COPIES THEREOF, INCLUDING ELECTRONIC MEDIA AND CAD FILES, ARE THE PROPERTY OF ARCHITECTS LEWIS + WHITLOCK, P.A. THEIR USE, REPRODUCTION OR REPRODUCTION OR ANY PURPOSE EXCEPT BY WRITTEN AGREEMENT WITH THE ARCHITECT IS PROHIBITED. THIS COPYRIGHT NOTIFICATION SHALL BE TRUE AS IF DIRECTLY PLACED ON EACH DRAWING EXHIBIT. NO RENDERING ON THIS DOCUMENT AND SHALL NOT BE REMOVED FROM THESE DOCUMENTS. | | | | | | | | | | | |
| Leon County Schools 3420 W. Tharpe St., Suite 100 Tallahassee, FL 32303 | | | | | | | | | | | |
| LCS Athletics Maintenance Building No. 3 Re-Roofing | | | | | | | | | | | |
| Client: | | | | | | | | | | | Job Title: |
| Consultant: | | | | | | | | | | | Project #: Phase: |
| Seal: | | | | | | | | | | | 24510.1 100% Construction Documents |



Architects Lewis + Whitlock
206 West Virginia St.
Tallahassee, Florida 32301
850.942.1718
www.think3d.net

Description:
Specifications

Sheet No.:

SP1.1

- A. A Substitution Request for products, assemblies, materials, and equipment constitutes a representation that the supplier:
 1. Has investigated proposed product and determined that it meets or exceeds the quality level of the specified product, equipment, assembly, or system.
 2. Agrees to provide the same warranty for the substitution as for the specified product.
 3. Agrees to provide same or equivalent maintenance service and source of replacement parts, as applicable.
 4. Agrees to coordinate installation and make changes to other work that may be required for the work to be complete, with no additional cost to Owner.
 5. Waives claims for additional costs or time extension that may subsequently become apparent.
 6. Agrees to reimburse Owner and Architect for review or redesign services associated with re-approval by authorities.
 - B. Document each request with complete data substantiating compliance of proposed substitution with Contract Documents. Burden of proof is on proposer.
 1. Note explicitly any non-compliant characteristics.
 - C. Content: Include information necessary for tracking the status of each Substitution Request, and information necessary to provide an actionable response.
 1. Forms included in the Project Manual are adequate for this purpose, and must be used.
 - D. Limit each request to a single proposed substitution item.
 1. Submit an electronic document, combining the request form with supporting data into single document.

3.02 SUBSTITUTION PROCEDURES DURING PROCUREMENT

 - A. Submittal Time Restrictions:
 1. Section 002113 - Instructions to Bidders specifies time restrictions and the documents required for submitting substitution requests during the bidding period.
 2. Owner will consider requests for substitutions only if submitted at least 10 days prior to the date for receipt of bids.
 - B. Submittal Form (before award of contract):
 1. Submit substitution requests by completing the form in Section 004325; see this section for additional information and instructions. Use only this form; other forms of submission are unacceptable.

3.03 SUBSTITUTION PROCEDURES DURING CONSTRUCTION

 - A. Submittal Form (after award of contract):
 1. Submit substitution requests by completing the form in Section 004325. Use only this form; other forms of submission are unacceptable.
 - B. Submit request for Substitution for Cause immediately upon discovery of need for substitution, but not later than 14 days prior to time required for review and approval by Architect, in order to stay on approved project schedule.
 - C. Submit request for Substitution for Convenience immediately upon discovery of its potential advantage to the project, but not later than 14 days prior to time required for review and approval by Architect, in order to stay on approved project schedule.
 1. In addition to meeting general documentation requirements, document how the requested substitution benefits the Owner through cost savings, time savings, greater energy conservation, or in other specific ways.
 2. Document means of coordinating of substitution item with other portions of the work, including work by affected subcontractors.
 3. Bear the costs engendered by proposed substitution of:
 - a. Owner's compensation to the Architect for any required redesign, time spent processing and evaluating the request.
 - b. Other construction by Owner.
 - c. Other unanticipated project considerations.
 - D. Substitutions will not be considered under one or more of the following circumstances:
 1. When they are indicated or implied on shop drawing or product data submittals, without having received prior approval.
 2. Without a separate written request.
 3. When acceptance will require revisions to Contract Documents.

3.04 RESOLUTION

 - A. Architect may request additional information and documentation prior to rendering a decision. Provide this data in an expeditious manner.
 - B. Architect will notify Contractor in writing of decision to accept or reject request.
 1. Architect's decision following review of proposed substitution will be noted on the submitted form.

3.05 ACCEPTANCE

 - A. Accepted substitutions change the work of the Project. They will be documented and incorporated into work of the project by Change Order, Construction Change Directive, Architectural Supplementary Instructions, or similar instruments provided for in the Conditions of the Contract.

3.06 CLOSEOUT ACTIVITIES

 - A. See Section 017800 - Closeout Submittals, for closeout submittals.
 - B. Include completed Substitution Request Forms as part of the Project record.

END OF SECTION 012500
SECTION 013000
ADMINISTRATIVE REQUIREMENTS

PART 1 GENERAL

1.01 SECTION INCLUDES

 - A. Electronic document submittal service.
 - B. Preconstruction meeting.
 - C. Progress meetings.
 - D. Progress photographs.
 - E. Coordination drawings.
 - F. Submittals for review, information, and project closeout.
 - G. Number of copies of submittals.
 - H. Submittal procedures.

PART 2 PRODUCTS - NOT USED

PART 3 EXECUTION

3.01 ELECTRONIC DOCUMENT SUBMITTAL SERVICE

 - A. All documents transmitted for purposes of administration of the contract are to be in electronic (PDF) format.
 1. This procedure applies to requests for information (RFIs), shop drawings, information submittals, field reports, meeting minutes, and any other document any participant wishes to make part of the project record.
 2. It is Contractor's responsibility to submit documents in allowable format.
 3. Paper document transmittals will not be reviewed.
 4. All other specified submittal and document transmission procedures apply, except that electronic document requirements do not apply to samples or color selection charts.

3.02 PRECONSTRUCTION MEETING

 - A. Schedule meeting after Notice of Award.
 - B. Attendance Required:
 1. Owner.
 2. Architect.
 3. Contractor.
 - C. Agenda:
 1. Submission of list of subcontractors, list of products, schedule of values, and progress schedule.
 2. Designation of personnel representing the parties to Contract.
 3. Scheduling.
 - D. Record minutes and distribute copies within two days after meeting to participants, with two copies to Architect, Owner, participants, and those affected by decisions made.

3.03 PROGRESS MEETINGS

 - A. Schedule and administer meetings throughout progress of the Work at maximum Bi-weekly intervals.
 - B. Make arrangements for meetings, prepare agenda with copies for participants, preside at meetings.
 - C. Attendance Required:
 1. Contractor.
 2. Owner.
 3. Architect.
 4. Contractor's superintendent.
 - D. Agenda:
 1. Review minutes of previous meetings.
 2. Review of work progress.
 3. Field observations, problems, and decisions.
 4. Identification of problems that impede, or will impede, planned progress.
 5. Review of submittals schedule and status of submittals.
 6. Maintenance of progress schedule.
 7. Corrective measures to regain projected schedules.
 8. Planned progress during succeeding work period.
 9. Maintenance of quality and work standards.
 10. Effect of proposed changes on progress schedule and coordination.
 11. Other business relating to work.
 - E. Record minutes and distribute copies within two days after meeting to participants, with two copies to Architect, Owner, participants, and those affected by decisions made.

3.04 PROGRESS PHOTOGRAPHS

 - A. Take photographs as evidence of existing project conditions as follows:

3.05 SUBMITTALS FOR REVIEW

 - A. When the following are specified in individual sections, submit them for review:
 1. Product data.

END OF SECTION 014000

SECTION 016000
PRODUCT REQUIREMENTS

PART 1 GENERAL

1.01 SECTION INCLUDES

- A. General product requirements.
- B. Sustainable design-related product requirements.
- C. Re-use of existing products.
- D. Transportation, handling, storage and protection.
- E. Product option requirements.
- F. Substitution limitations.
- G. Maintenance materials, including extra materials, spare parts, tools, and software.

1.02 RELATED REQUIREMENTS

- A. Section 012500 - Substitution Procedures: Substitutions made during procurement and/or construction phases.
- B. Section 013329.02 - Sustainable Design Reporting - LEED v4: Reporting requirements.
- C. Section 017419 - Construction Waste Management and Disposal: Waste disposal requirements potentially affecting product selection, packaging and substitutions.

1.03 SUBMITTALS

- A. Product Data Submittals: Submit manufacturer's standard published data. Mark each copy to identify applicable products, models, options, and other data. Supplement manufacturers' standard data to provide information specific to this Project.
- B. Shop Drawing Submittals: Prepared specifically for this Project, indicate utility and electrical characteristics, utility connection requirements, and location of utility outlets for service for functional equipment and appliances.
- C. Sample Submittals: Illustrate functional and aesthetic characteristics of the product, with integral parts and attachment devices. Coordinate sample submittals for interfacing work.
1. For selection from standard finishes, submit samples of the full range of the manufacturer's standard colors, textures, and patterns.
- D. Sustainable Design Submittals: Items necessary to document use of sustainable construction materials products, and practices.
1. See Section 013329.02 for Contractor's reporting necessary for achievement of targeted LEED v4 certification level.

1.04 QUALITY ASSURANCE

- A. Chain-of-Custody (COC): A procedure that tracks a product from the point of harvest or extraction to its end use, including successive stages of processing, transformation, manufacturing, and distribution.
- B. Chain-of-Custody Certificates: Certificates signed by manufacturers and fabricators certifying that wood used to make products was obtained from forests certified by an FSC-accredited certification body to comply with FSC STD-01-001.
- C. Composite Wood and Agrifibre: Products made of wood particles and/or plant material pressed and bonded with adhesive or resin such as particleboard, medium density fiberboard (MDF), plywood, wheatboard, strawboard, panel substrates, and door cores.
- D. Corporate Sustainability Report: A third-party verified report that outlines the environmental impacts of extraction operations and activities associated with the manufacturer's product and the product's supply chain.
- E. Cradle-to-Cradle Certified: End use product certified Cradle-to-Cradle v2 Basic or Cradle-to-Cradle v3 Bronze, minimum, as evidenced by C2C (DIR).
- F. Environmental Product Declaration (EPD): Publicly available, critically reviewed life cycle analysis having at least a cradle-to-gate scope.
 - 1. Good: Product-specific; compliant with ISO 14044.
 - 2. Better: Industry-wide, generic; compliant with ISO 21930, or with ISO 14044, ISO 14040, ISO 14025, and EN 15804; Type III third-party certification with external verification, in which the manufacturer is recognized as the program operator.
 - 3. Best: Commercial-product-specific; compliant with ISO 21930, or with ISO 14044, ISO 14040, ISO 14025, and EN 15804; Type III third-party certification with external verification, in which the manufacturer is recognized as the program operator.
 - 4. Where demonstration of impact reduction below industry average is required, submit both industry-wide and commercial-product-specific declarations; or submit at least 5 declarations for products of the same type by other manufacturers in the same industry.
- G. GreenScreen Chemical Hazard Analysis: Ingredients of 100 parts-per-million or greater evaluated using GreenScreen (METH).
 - 1. Good: GreenScreen (LIST) evaluation to identify Benchmark 1 hazards; a Health Product Declaration includes this information.
 - 2. Better: GreenScreen Full Assessment.
 - 3. Best: GreenScreen Full Assessment by GreenScreen Licensed Profiler.
 - 4. Acceptable Evidence: GreenScreen report.
- H. Health Product Declarations (HPD): Complete, published declaration with full disclosure of known hazards, prepared using one of the HPDC (HPD-OLT) online tools.
- I. Leadership Extraction Practices: Products that meet at least one of the responsible extraction criteria, which include: extended producer responsibility bio-based materials; FSC wood products; materials reuse; recycled content; and other programs approved by sustainability certification system used for the project.
- J. Manufacturer's Inventory of Product Content: Publicly available inventory of every ingredient identified by name and Chemical Abstract Service Registration Number (CAS RN).
 - 1. For ingredients considered a trade secret or intellectual property, the name and CAS RN may be omitted, provided the ingredient's role, amount, and GreenScreen Benchmark are given.
- K. Rapidly Renewable Materials: Made from agricultural products that are typically harvested within a 10-year or shorter cycle.
- L. Regional Materials: Materials that are extracted, harvested, recovered, and manufactured within a radius of 100 miles from the Project site.
- M. Reused Products: Materials and equipment previously used in this or other construction, salvaged and refurbished as specified.
- N. Source Location: Location of harvest, extraction, recovery, or manufacture; where information about source location is required to be submitted, give the postal address:
 - 1. In every case, indicate the location of final assembly.
 - 2. For harvested products, indicate location of harvest.
 - 3. For extracted (i.e. mined) products, indicate location of extraction.
 - 4. For recovered products, indicate location of recovery.
 - 5. For products involving multiple manufacturing steps, provide a description of the process at each step, with location.
 - 6. Acceptable Evidence:
 - a. Manufacturer's certification.
 - b. Life cycle analysis (LCA) performed by third-party.

PART 2 PRODUCTS

2.01 EXISTING PRODUCTS

- A. Do not use materials and equipment removed from existing premises unless specifically required or permitted by the Contract Documents.
- B. Existing materials and equipment indicated to be removed, but not to be re-used, relocated, reinstalled, delivered to the Owner, or otherwise indicated as to remain the property of the Owner, become the property of the Contractor; remove from site.

2.02 NEW PRODUCTS

- A. Provide new products unless specifically required or permitted by the Contract Documents.
- B. All new exterior envelope products must be Florida Product Approved. Provide Notice of Acceptance documentation with submittals.
- C. Use of products having any of the following characteristics is not permitted:
1. Made using or containing CFC's or HCFC's.
 2. Containing lead, cadmium, or asbestos.
- D. Where other criteria are met, Contractor shall give preference to products that:
1. Have longer documented life span under normal use.
 2. Result in less construction waste. See Section 017419
 3. Are made of recycled materials.
 4. Are Cradle-to-Cradle Certified.
 5. Have a published Environmental Product Declaration (EPD).
 6. Have a published Health Product Declaration (HPD).

2.03 PRODUCT OPTIONS

- A. Products Specified by Reference Standards or by Description Only: Use any product meeting those standards or description.
- B. Products Specified by Naming One or More Manufacturers: Use a product of one of the manufacturers named and meeting specifications, no options or substitutions allowed.
- C. Products Specified by Naming One or More Manufacturers with a Provision for Substitutions: Submit a request for substitution for any manufacturer not named.

PART 3 EXECUTION

3.01 SUBSTITUTION LIMITATIONS


- A. See Section 012500 - Substitution Procedures.

3.02 TRANSPORTATION AND HANDLING

- A. Package products for shipment in manner to prevent damage; for equipment, packaging to avoid loss of factory calibration.
- B. If special precautions are required, attach instructions prominently and legibly on outside of packaging.
- C. Coordinate schedule of product delivery to designated prepared areas in order to minimize site storage time and potential damage to stored materials.
- D. Transport and handle products in accordance with manufacturer's instructions.
- E. Transport materials in covered trucks to prevent contamination of product and littering of surrounding areas.
- F. Promptly inspect shipments to ensure that products comply with requirements, quantities are correct, and products are undamaged.
- G. Provide equipment and personnel to handle products by methods to prevent soiling, disfigurement, or damage, and to minimize handling.
- H. Arrange for the return of packing materials, such as wood pallets, where economically feasible.

3.03 STORAGE AND PROTECTION

- A. Designate receiving/storage areas for incoming products so that they are delivered according to installation schedule and placed convenient to work area in order to minimize waste due to excessive materials handling and misapplication. See Section 017419.
- B. Store and protect products in accordance with manufacturers' instructions.
- C. Store with seals and labels intact and legible.

| Seal: | Consultant: | Client: | <div><p>Leon County Schools 3420 W. Tharpe St., Suite 100 Tallahassee, FL 32303</p></div> | <table><tr><th>PHASE:</th><th>DRAWN:</th><th>REVIEWED:</th><th>DATE:</th><th>ID:</th><th>REVISION:</th><th>DRAWN:</th><th>REVIEWED:</th><th>DATE:</th></tr><tr><td>CONCEPT SCHEM DESIGN</td><td></td><td></td><td></td><td></td><td></td><td></td><td></td><td></td></tr><tr><td>ADVANCED SCHEM DESIGN</td><td></td><td></td><td></td><td></td><td></td><td></td><td></td><td></td></tr><tr><td>50% CONSTRUCTION DOCS</td><td></td><td></td><td></td><td></td><td></td><td></td><td></td><td></td></tr><tr><td>90% CONSTRUCTION DOCS</td><td></td><td></td><td></td><td></td><td></td><td></td><td></td><td></td></tr><tr><td>PERMIT DOCS</td><td></td><td></td><td></td><td></td><td></td><td></td><td></td><td></td></tr><tr><td>100% CONSTRUCTION DOCS</td><td>18.B.</td><td>C. WHITLOCK</td><td>10/26/2024</td><td></td><td></td><td></td><td></td><td></td></tr></table> | PHASE: | DRAWN: | REVIEWED: | DATE: | ID: | REVISION: | DRAWN: | REVIEWED: | DATE: | CONCEPT SCHEM DESIGN | | | | | | | | | ADVANCED SCHEM DESIGN | | | | | | | | | 50% CONSTRUCTION DOCS | | | | | | | | | 90% CONSTRUCTION DOCS | | | | | | | | | PERMIT DOCS | | | | | | | | | 100% CONSTRUCTION DOCS | 18.B. | C. WHITLOCK | 10/26/2024 | | | | | |
|---|
| PHASE: | DRAWN: | REVIEWED: | DATE: | ID: | REVISION: | DRAWN: | REVIEWED: | DATE: | |
| CONCEPT SCHEM DESIGN | |
| ADVANCED SCHEM DESIGN | |
| 50% CONSTRUCTION DOCS | |
| 90% CONSTRUCTION DOCS | |
| PERMIT DOCS | |
| 100% CONSTRUCTION DOCS | 18.B. | C. WHITLOCK | 10/26/2024 | |
| Project #: | 24510.1 | Job Title: | LCS Athletics Maintenance Building No. 3 Re-Roofing | THESE DRAWINGS AND REVISIONS ARE INSTRUMENTS OF SERVICE. THE DRAWINGS AND ASSOCIATED COPIES THEREOF, INCLUDING ELECTRONIC MEDIA AND CAD FILES, ARE THE PROPERTY OF ARCHITECT'S LEVINS + WHITLOCK P.A.A. THEIR USE, REPRESENTATION OR REPRODUCTION FOR ANY PURPOSE EXCEPT BY WRITTEN AGREEMENT WITH THE ARCHITECT IS PROHIBITED. THIS COPYRIGHT NOTIFICATION SHALL BE TRUE AS IF DIRECTLY PLACED ON EACH DRAWING EXHIBIT OR REVISIONS ON THIS DOCUMENT AND SHALL BE REMOVED FROM THESE DOCUMENTS IF | |
| Phase: | 100% Construction Documents | |

- C. Where metal will be in contact with wood or other absorbent material subject to wetting, seal joints with sealing compound and apply one coat of heavy-bodied bituminous paint.
- 3.03 INSTALLATION**
- A. Overall: Install roofing system in accordance with approved shop drawings and panel manufacturer's instructions and recommendations, as applicable to specific project conditions. Anchor all components of roofing system securely in place while allowing for thermal and structural movement.
1. Install roofing system with concealed clips and fasteners, except as otherwise recommended by manufacturer for specific circumstances.
2. Minimize field cutting of panels. Where field cutting is absolutely required, use methods that will not distort panel profiles. Use of torches for field cutting is absolutely prohibited.
- B. Accessories: Install all components required for a complete roofing assembly, including flashings, gutters, downspouts, trim, moldings, closure strips, caps, equipment curbs, rib closures, ridge closures, and similar roof accessory items.
- C. Roof Panels: Install panels in strict accordance with manufacturer's instructions, minimizing transverse joints except at junction with penetrations.
1. Form weathertight standing seams incorporating concealed clips, using an automatic mechanical seaming device approved by the panel manufacturer.
2. Incorporate concealed clips at panel joints, and apply snap-on battens to provide weathertight joints.
3. Provide sealant tape or other approved joint sealer at lapped panel joints.
4. Install sealant or sealant tape, as recommended by panel manufacturer, at end laps and side joints.
- D. Insulation: Install insulation between roof covering and supporting members to present a neat appearance. Fold, staple, and tape seams unless otherwise approved by Architect.
- 3.04 CLEANING**
- A. Clean exposed sheet metal work at completion of installation. Remove grease and oil films, excess joint sealer, handling marks, and debris from installation, leaving the work clean and unmarked, free from dents, creases, waves, scratch marks, or other damage to the finish.

- 3.05 PROTECTION**
- A. Do not permit storage of materials or roof traffic on installed roof panels. Provide temporary walkways or planks as necessary to avoid damage to completed work. Protect roofing until completion of project.
- B. Touch-up, repair, or replace damaged roof panels or accessories before Date of Substantial Completion.

END OF SECTION 074113

SECTION 074213
METAL WALL PANELS

- PART 1 GENERAL**
- 1.01 SECTION INCLUDES**
- A. Metal wall panel system.
- 1.02 REFERENCE STANDARDS**
- A. ASTM D1970/D1970M - Standard Specification for Self-Adhering Polymer Modified Bituminous Sheet Materials Used as Steep Roofing Underlayment for Ice Dam Protection; 2013.
- 1.03 SUBMITTALS**
- A. See Section 013000 - Administrative Requirements for submittal procedures.
- B. Product Data - Wall System: Manufacturer's data sheets on each product used, including:
1. Physical characteristics of components shown on shop drawings.
2. Storage and handling requirements and recommendations.
3. Installation instructions and recommendations.
- C. Manufacturer's qualification statement.
- D. Installer's qualification statement.
- 1.04 QUALITY ASSURANCE**
- A. Manufacturer Qualifications: Company specializing in manufacturing products specified in this section with minimum three years of documented experience.
- B. Installer Qualifications: Company specializing in installing products specified in this section with minimum three years of documented experience.
- 1.05 DELIVERY, STORAGE, AND HANDLING**
- A. Protect panels from accelerated weathering by removing or venting sheet plastic shipping wrap.
- B. Store prefinished material off the ground and protect it from weather; prevent twisting, bending, or abrasion; provide ventilation; slope metal sheets to ensure proper drainage.
- C. Prevent contact with materials that cause discoloration or staining of products.
- 1.06 FIELD CONDITIONS**
- A. Do not install wall panels when air temperature or relative humidity is outside manufacturer's limits.

PART 2 PRODUCTS

- 2.01 MANUFACTURERS**
- A. Metal Wall Panels - Exposed Fasteners:
1. Berridge Manufacturing Company; M Panel: www.berridge.com/#sle.
2. Substitutions: See Section 016000 - Product Requirements.
- 2.02 METAL WALL PANEL SYSTEM**
- A. Wall Panel System: Factory-fabricated prefinished metal panel system, site assembled.
1. Provide exterior wall panels.
2. Size components to support assembly dead loads and withstand live loads caused by positive and negative wind pressure acting normally to plane of wall.
3. Maximum Allowable Deflection of Panel: L/180 for length (L) of span.
4. Movement: Accommodate movement within system without damage to components or deterioration of seals, movement between system and perimeter components when subject to seasonal temperature cycling, dynamic loading and release of loads, and deflection of structural support framing.
5. Drainage: Provide positive drainage to exterior for moisture entering or condensation occurring within panel system.
6. Fabrication: Formed true to shape, accurate in size, square, and free from distortion or defects; pieces of longest practical lengths.
- B. Exterior Wall Panels:
1. Profile: Vertical.
2. Side Seams: Interlocking.
3. Panel Width:
- a. M Panel: 36 inches
4. Color: As selected by Architect from manufacturer's standard line.
- C. Internal and External Corners: Same material, thickness, and finish as exterior sheets; profile to suit system; shop-cut to required angles.
- D. Trim: Same material, thickness and finish as exterior sheets; brake formed to required profiles.
- E. Anchors: Galvanized steel.
- 2.03 ACCESSORIES**
- A. Exposed Sealant: Elastomeric; silicone, polyurethane, or silyl-terminated polyether/polyurethane, compatible with PVDF paint system.
- B. Fasteners: Manufacturer's standard type to suit application; with soft neoprene washers, stainless steel.
1. Metal-to-Metal Fasteners: Self-drilling, self-lapping screws, coated and corrosion-resistant.
- C. Field Touch-Up Paint: As recommended by panel manufacturer.
- D. Underlayment: Self-adhering polymer modified asphalt sheet complying with ASTM D1970/D1970M, with strippable release film and top surface of woven polypropylene sheet.

PART 3 EXECUTION

- 3.01 EXAMINATION**
- A. Verify building framing members ready to receive panels.
- B. Verify wall panel substrate ready to receive panels; see Section 054000.
- C. Weather Barrier:
- 3.02 PREPARATION**
- A. Protect surrounding areas and adjacent surfaces from damage during execution of this work.
- 3.03 INSTALLATION**
- A. Install panels on walls in accordance with manufacturer's instructions.
- B. Protect surfaces in contact with cementitious materials and dissimilar metals with bituminous paint; allow to dry prior to wall panel installation.
- C. Fasten panels to structural supports; align, level, and plumb.
- D. Locate joints over supports.
- E. Lap panel ends 4 inches wide, minimum.
- F. Seal and place gaskets to prevent weather penetration. Maintain neat appearance.
- 3.04 TOLERANCES**
- A. Offset From True Alignment Between Adjacent Members Abutting or In-Line: 1/4 inch in 20 feet wide, maximum.
- B. Variation from Plane or Location As Indicated on Drawings: 1/4 inch wide, maximum.
- 3.05 CLEANING**
- A. Remove site cuttings from finish surfaces.
- B. Remove protective material from wall panel surfaces.
- 3.06 PROTECTION**
- A. Protect metal wall panels until completion of project.
- B. Touch up, repair, or replace damaged wall panels or accessories before Date of Substantial Completion.

END OF SECTION 074213

SECTION 077123
MANUFACTURED GUTTERS AND DOWNSPOUTS

- PART 1 GENERAL**
- 1.01 SECTION INCLUDES**
- A. Pre-finished aluminum gutters and downspouts.
- 1.02 ADMINISTRATIVE REQUIREMENTS**
- A. Comply with SMACNA (ASMM) for sizing components for rainfall intensity determined by a storm occurrence of 1 in 10 years.
- B. Comply with applicable code for size and method of rain water discharge.
- 1.03 SUBMITTALS**
- A. See Section 013000 - Administrative Requirements for submittal procedures.
- B. Product Data: Provide data on prefabricated components.
- C. Shop Drawings: Indicate locations, configurations, jointing methods, fastening methods, locations, and installation details.
- 1.04 DELIVERY, STORAGE, AND HANDLING**
- A. Stack material to prevent twisting, bending, or abrasion, and to provide ventilation. Slope to drain.
- B. Prevent contact with materials that could cause discoloration, staining, or damage.
- PART 2 PRODUCTS**
- 2.01 MANUFACTURERS**
- A. Gutters and Downspouts:
1. Englert, Inc: www.englertinc.com.
2. MBCI: www.mbc.com.
3. Petersen Aluminum Corporation: www.pac-clad.com.
- 2.02 MATERIALS**
- A. Aluminum Sheet: ASTM B209/B209M; 0.032 inch thick.
1. Finish: Class I anodized.
2. Color: Clear.
- 2.03 COMPONENTS**
- A. Gutters: Profile as indicated.
- B. Downspouts: Profile as indicated.
- C. Anchors and Supports: Profiled to suit gutters and downspouts.
1. Anchoring Devices: In accordance with CDA requirements.
2. Gutter Supports: Straps.
3. Downspout Supports: Brackets.
- D. Fasteners: Same material and finish as gutters and downspouts , with soft neoprene washers.
- 2.04 ACCESSORIES**
- A. Splash Pads: Precast concrete type, profiles size(s) as indicated; minimum 3,000 psi compressive strength at 28 days, with minimum 5 percent air entrainment.
- PART 3 EXECUTION**
- 3.01 EXAMINATION**
- A. Verify that surfaces are ready to receive work.
- 3.02 INSTALLATION**
- A. Install gutters, downspouts, and accessories in accordance with manufacturer's instructions.
- B. Slope gutters min. 1/4" per 10' (or as required by code).
- END OF SECTION 077123
SECTION 079200
JOINT SEALANTS

- PART 1 GENERAL**
- 1.01 SECTION INCLUDES**
- A. Nonsag gunnable joint sealants.
- B. Joint backings and accessories.
- 1.02 SUBMITTALS**
- A. Product Data for Sealants: Submit manufacturer's technical data sheets for each product to be used, that includes the following.
1. Physical characteristics, including movement capability, VOC content, hardness, cure time, and color availability.
2. List of backing materials approved for use with the specific product.
3. Substrates that product is known to satisfactorily adhere to and with which it is compatible.
4. Substrates the product should not be used on.
- B. Product Data for Accessory Products: Submit manufacturer's technical data sheet for each product to be used, including physical characteristics, installation instructions, and recommended tools.
- C. Color Cards for Selection: Where sealant color is not specified, submit manufacturer's color cards showing standard colors available for selection.
- D. Sustainable Design Documentation: For sealants and primers, submit VOC content and emissions documentation; see Section 016116.
- 1.03 QUALITY ASSURANCE**
- A. Maintain one copy of each referenced document covering installation requirements on site.
- B. Manufacturer Qualifications: Company specializing in manufacturing the products specified in this section with minimum three years documented experience.
- C. Installer Qualifications: Company specializing in performing the work of this section and with at least three years of documented experience.
- D. Field Quality Control Plan:
1. Inspection and testing to be performed by the manufacturer's representative.
2. Visual inspection of entire length of sealant joints.
3. Non-destructive field adhesion testing of sealant joints.
- a. For each different sealant and substrate combination, allow for one test every 12 inches in the first 10 linear feet of joint and one test every 24 inches thereafter.
- b. If any failures occur in the first 10 linear feet, continue testing at 12 inches intervals at no extra cost to Owner.
- E. Field Adhesion Tests of Joints: Test for adhesion using most appropriate method in accordance with ASTM C1521, or other applicable method as recommended by manufacturer.
- 1.04 WARRANTY**
- A. Correct defective work within a five year period after Date of Substantial Completion.
- B. Warranty: Include coverage for installed sealants and accessories that fail to achieve watertight seal , exhibit loss of adhesion or cohesion, or do not cure.
- PART 2 PRODUCTS**
- 2.01 MANUFACTURERS**
- A. Non-Sag Sealants: Permits application in joints on vertical surfaces without sagging or slumping.
1. Dow Chemical Company: consumer.dow.com/en-us/industry/ind-building-construction.html/#sle.
2. Pecora Corporation: www.pecora.com/#sle.
3. Sika Corporation: www.usa-sika.com/#sle.
4. Tremco Commercial Sealants & Waterproofing: www.tremcosealants.com/#sle.
- 2.02 JOINT SEALANT APPLICATIONS**
- A. Scope:
1. Exterior Joints: Seal open joints, whether or not the joint is indicated on drawings, unless specifically indicated not to be sealed. Exterior joints to be sealed include, but are not limited to, the following items.
- a. Joints between different exposed materials.
- b. Do not seal the following types of joints.
- a. Joints indicated to be treated with manufactured expansion joint cover or some other type of sealing device.
- b. Joints where sealant is specified to be provided by manufacturer of product to be sealed.
- c. Joints where installation of sealant is specified in another section.
- B. Exterior Joints: Use nonsag non-staining silicone sealant, unless otherwise indicated.
- 2.03 JOINT SEALANTS - GENERAL**
- A. Sealants and Primers: Provide products having lower volatile organic compound (VOC) content than indicated in SCAQMD 1168.
- B. Colors: As indicated on drawings.
- 2.04 NONSAG JOINT SEALANTS**
- A. Non-Staining Silicone Sealant: ASTM C920, Grade NS, Uses M and A; not expected to withstand continuous water immersion or traffic.
1. Movement Capability: +100/-50%, minimum.
2. Dirt Pick-Up: Reduced dirt pick-up compared to other silicone sealants.
3. Color: To be selected by Architect from manufacturer's standard range.
4. Service Temperature Range: Minus 20 to 180 degrees F.
- 2.05 ACCESSORIES**
- A. Backer Rod: Cylindrical cellular foam rod with surface that sealant will not adhere to, compatible with specific sealant used, and recommended by backing and sealant manufacturers for specific application.
1. Open Cell: 40 to 50 percent larger in diameter than joint width.
- B. Backing Tape: Self-adhesive polyethylene tape with surface that sealant will not adhere to and recommended by tape and sealant manufacturers for specific application.

- C. Masking Tape: Self-adhesive, nonabsorbent, non-staining, removable without adhesive residue, and compatible with surfaces adjacent to joints and sealants.
- D. Joint Cleaner: Non-corrosive and non-staining type, type recommended by sealant manufacturer; compatible with joint forming materials.
- E. Primers: Type recommended by sealant manufacturer to suit application; non-staining.

PART 3 EXECUTION

- 3.01 EXAMINATION**
- A. Verify that joints are ready to receive work.
- B. Verify that backing materials are compatible with sealants.
- C. Verify that backer rods are of the correct size.
- 3.02 PREPARATION**
- A. Remove loose materials and foreign matter that could impair adhesion of sealant.
- B. Clean joints, and prime as necessary, in accordance with manufacturer's instructions.
- C. Perform preparation in accordance with manufacturer's instructions and ASTM C1193.
- D. Mask elements and surfaces adjacent to joints from damage and disfigurement due to sealant work; be aware that sealant drips and smears may not be completely removable.

- 3.03 INSTALLATION**
- A. Perform work in accordance with sealant manufacturer's requirements for preparation of surfaces and material installation instructions.
- B. Perform installation in accordance with ASTM C1193.
- C. Install bond breaker backing tape where backer rod cannot be used.
- D. Install sealant free of air pockets, foreign embedded matter, ridges, and sags, and without getting sealant on adjacent surfaces.
- E. Do not install sealant when ambient temperature is outside manufacturer's recommended temperature range, or will be outside that range during the entire curing period, unless manufacturer's approval is obtained and instructions are followed.
- F. Nonsag Sealants: Tool surface concave, unless otherwise indicated; remove masking tape immediately after tooling sealant surface.

- 3.04 FIELD QUALITY CONTROL**
- A. Perform field quality control inspection/testing as specified in PART 1 under QUALITY ASSURANCE article.
- B. Non-Destructive Adhesion Testing: If there are any failures in first 100 linear feet, notify Architect immediately.
- C. Remove and replace failed portions of sealants using same materials and procedures as indicated for original installation.

- 3.05 POST-OCCUPANCY**
- A. Post-Occupancy Inspection: Perform visual inspection of entire length of project sealant joints at a time that joints have opened to their greatest width; i.e. at low temperature in thermal cycle. Report failures immediately and repair.

END OF SECTION 079200

| PHASE: | DRAWN: | REVIEWED: | DATE: | ID: | REVISION: | DRAWN: | REVIEWED: | DATE: |
|---|--------|-----------|---|-----|----------------|---------------------------------------|-----------|-----------|
| CONCEPT SCHEM. DESIGN | BB | R. Lewis | 2/7/2025 | 1 | Addendum No. 2 | BB | R. Lewis | 2/7/2025 |
| ADVANCED SCHEM. DESIGN | BB | R. Lewis | 2/20/2025 | 2 | Addendum No. 3 | BB | R. Lewis | 2/20/2025 |
| 50% CONSTRUCTION DOCS | | | | | | | | |
| 80% CONSTRUCTION DOCS | | | | | | | | |
| PERMIT DOCS | | | | | | | | |
| 100% CONSTRUCTION DOCS | | | | | | | | |
| THREE DRAWINGS AND PERMITS REQUIRED FOR COMMENCEMENT OF SERVICE. THE DRAWINGS AND ASSOCIATED COPIES THEREOF, INCLUDING ELECTRONIC FILES, SHALL BE KEPT ON FILE FOR A MINIMUM OF FIVE (5) YEARS AFTER THE DATE OF COMPLETION OF THE PROJECT. THIS COPYRIGHT NOTIFICATION SHALL BE TRUE AS IF DIRECTLY PLACED ON EACH DRAWING EXHIBIT, OVERLAPPING ON THE DOCUMENT AND SHALL NOT BE REMOVED FROM THESE DOCUMENTS. | | | | | | | | |
| Client: | | | Leon County Schools Tallahassee, Florida | | | Job Title: | | |
| Consultant: | | | | | | Project #: 24510.1 | | |
| Seal: | | | | | | Phase: 100% Construction Documents | | |





Architects Lewis + Whitlock
206 West Virginia St.
Tallahassee, Florida 32301
850.942.1718
www.think3d.net

Description:
Specifications

Sheet No.:

SP1.4

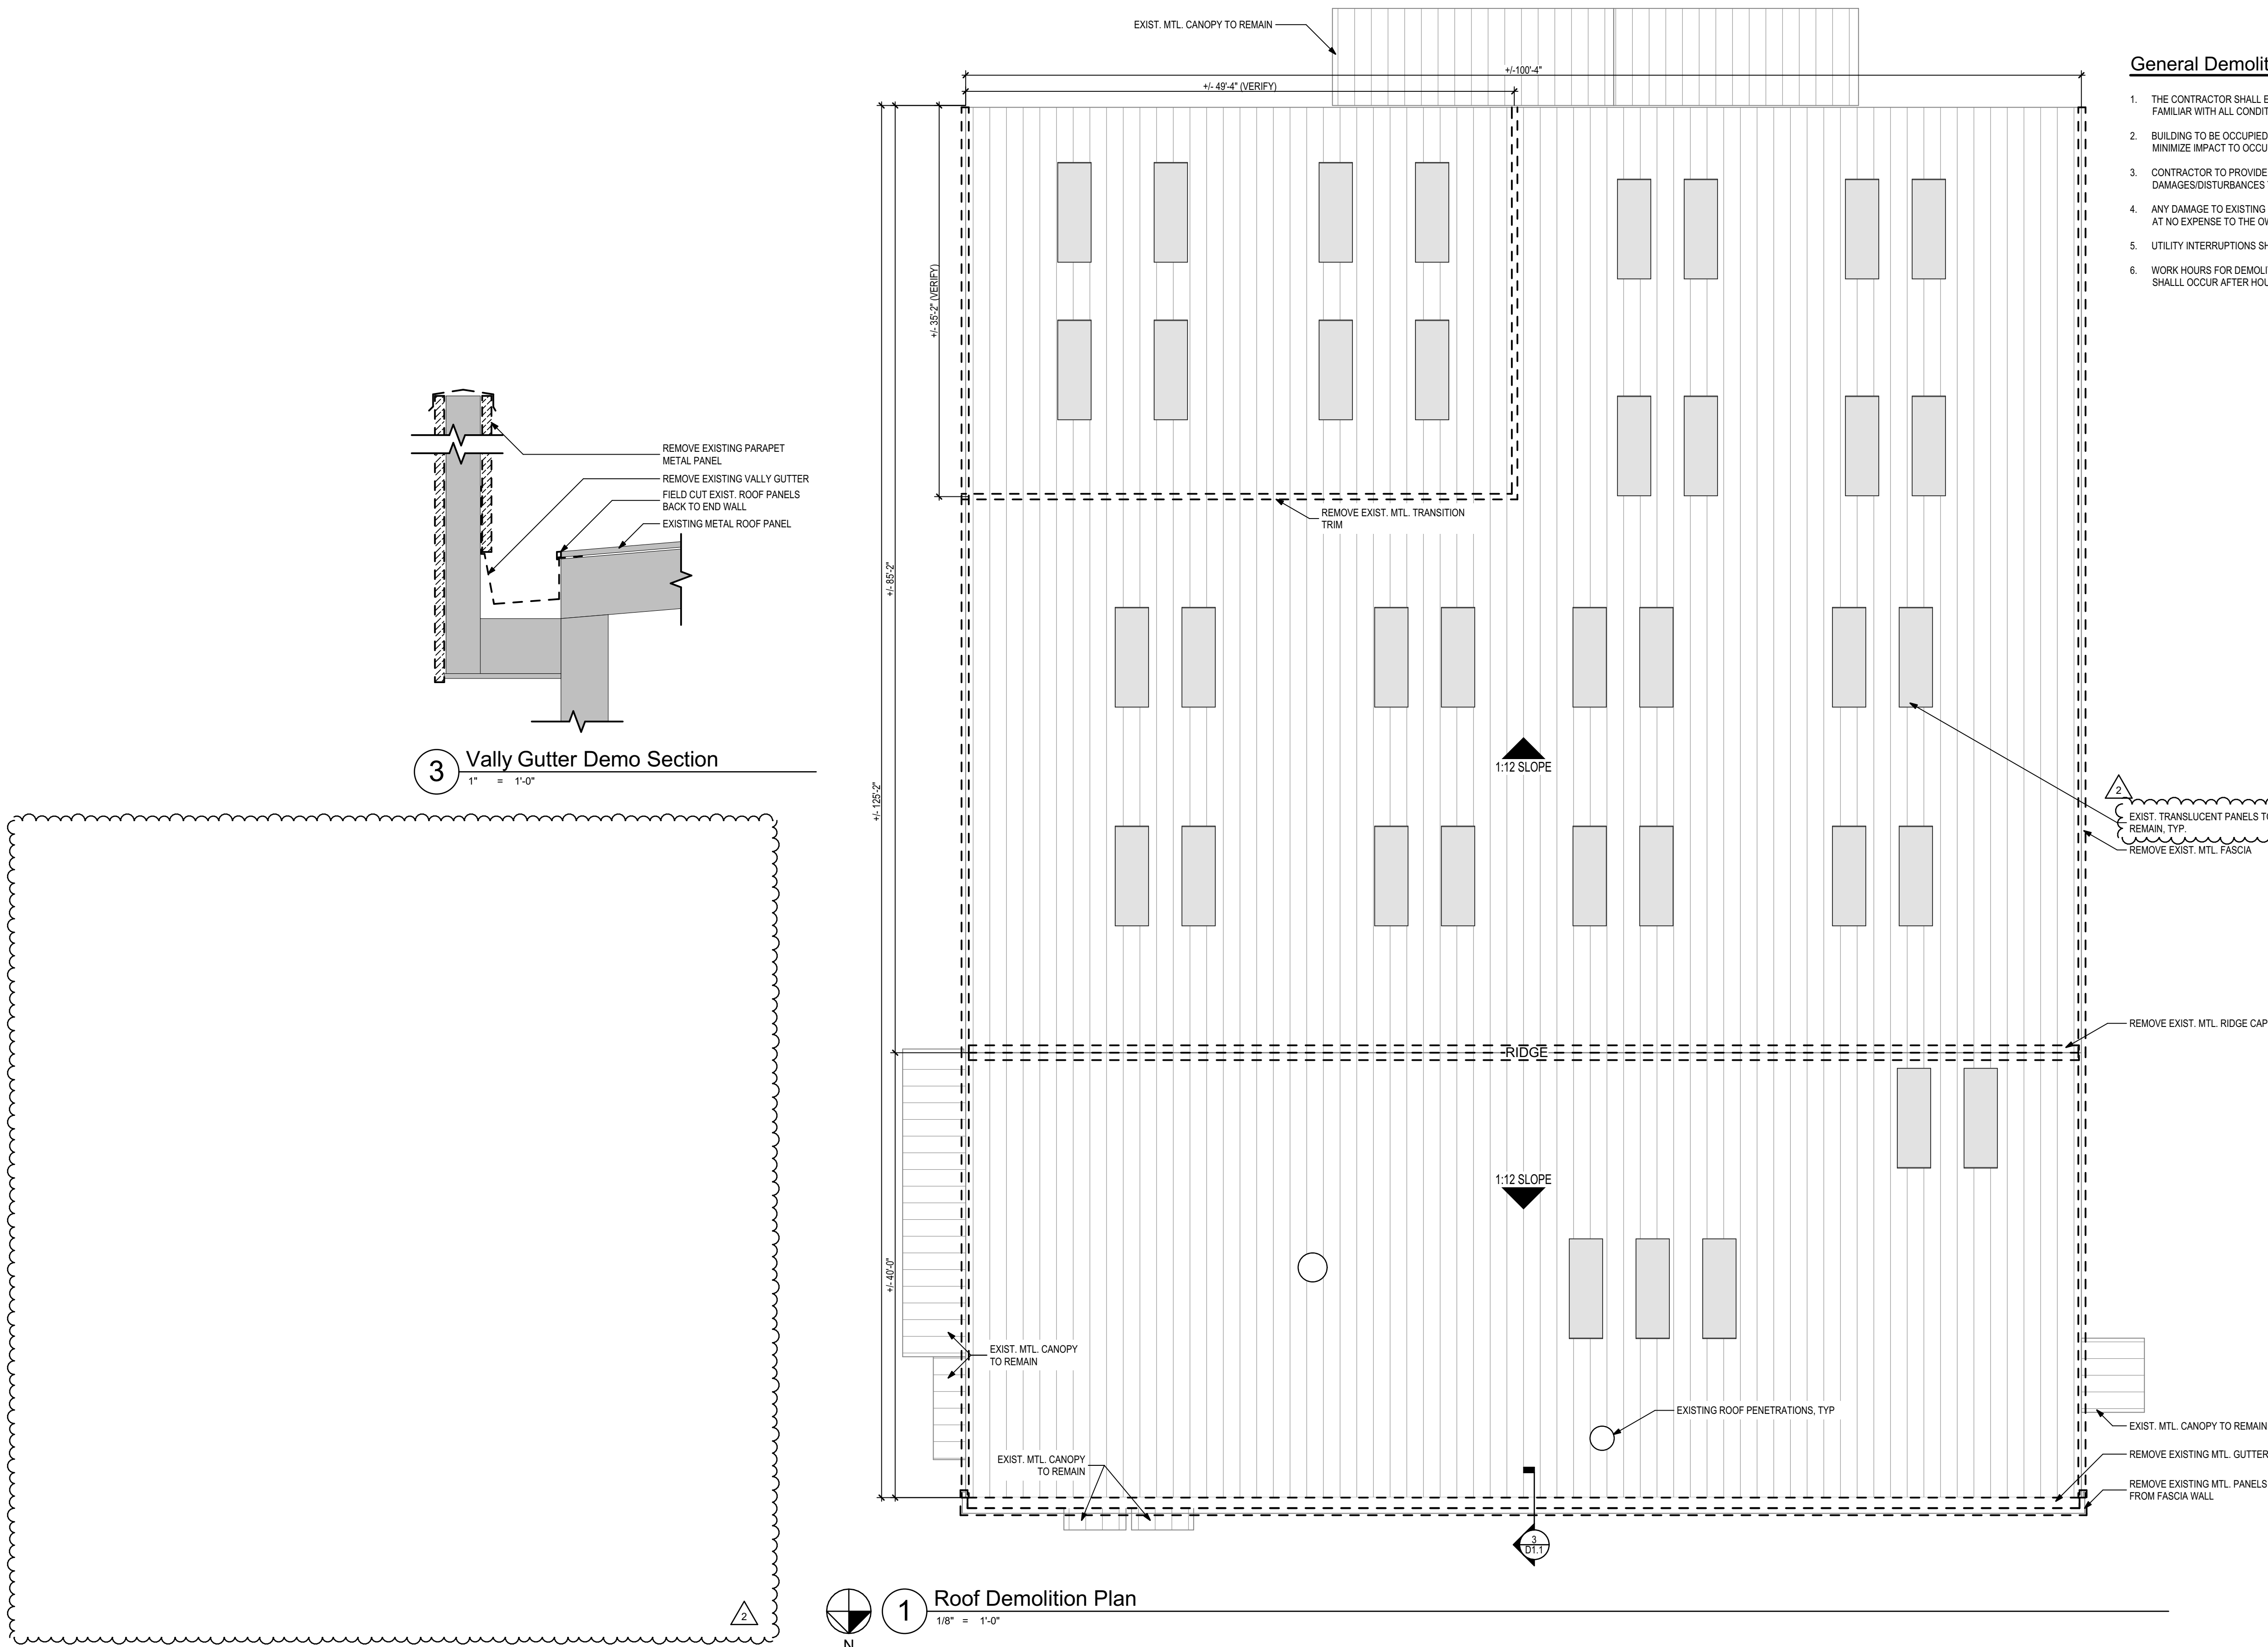

| Seal: | Consultant: | Client: | <div><div><div>Leon County Schools</div><div>3420 W. Tharpe St., Suite 100 Tallahassee, FL 32303</div></div><div></div></div> | |
|---|
| Project #: | 24510.1 | Job Title: | LCS Athletics Maintenance Building | |
| Phase: | 100% Construction Documents | | No. 3 Re-Roofing | |
| <table><tr><th>PHASE:</th><th>DRAWN:</th><th>REVIEWED:</th><th>DATE:</th><th>ID:</th><th>REVISION:</th><th>DRAWN:</th><th>REVIEWED:</th><th>DATE:</th></tr><tr><td>CONCEPT SCHEM. DESIGN</td><td></td><td></td><td></td><td>1</td><td>Addendum No. 1</td><td>B.B.</td><td>R. Lewis</td><td>2/2/2025</td></tr><tr><td>ADVANCED SCHEM. DESIGN</td><td></td><td></td><td></td><td>2</td><td>Addendum No. 2</td><td>B.B.</td><td>R. Lewis</td><td>2/7/2025</td></tr><tr><td>50% CONSTRUCTION DOCS</td><td></td><td></td><td></td><td></td><td></td><td></td><td></td><td></td></tr><tr><td>90% CONSTRUCTION DOCS</td><td></td><td></td><td></td><td></td><td></td><td></td><td></td><td></td></tr><tr><td>PERMIT DOCS</td><td></td><td></td><td></td><td></td><td></td><td></td><td></td><td></td></tr><tr><td>100% CONSTRUCTION DOCS</td><td>B.B.</td><td>C. WHITLOCK</td><td>10/25/2024</td><td></td><td></td><td></td><td></td><td></td></tr></table> | | | | PHASE: | DRAWN: | REVIEWED: | DATE: | ID: | REVISION: | DRAWN: | REVIEWED: | DATE: | CONCEPT SCHEM. DESIGN | | | | 1 | Addendum No. 1 | B.B. | R. Lewis | 2/2/2025 | ADVANCED SCHEM. DESIGN | | | | 2 | Addendum No. 2 | B.B. | R. Lewis | 2/7/2025 | 50% CONSTRUCTION DOCS | | | | | | | | | 90% CONSTRUCTION DOCS | | | | | | | | | PERMIT DOCS | | | | | | | | | 100% CONSTRUCTION DOCS | B.B. | C. WHITLOCK | 10/25/2024 | | | | | |
| PHASE: | DRAWN: | REVIEWED: | DATE: | ID: | REVISION: | DRAWN: | REVIEWED: | DATE: | |
| CONCEPT SCHEM. DESIGN | | | | 1 | Addendum No. 1 | B.B. | R. Lewis | 2/2/2025 | |
| ADVANCED SCHEM. DESIGN | | | | 2 | Addendum No. 2 | B.B. | R. Lewis | 2/7/2025 | |
| 50% CONSTRUCTION DOCS | |
| 90% CONSTRUCTION DOCS | |
| PERMIT DOCS | |
| 100% CONSTRUCTION DOCS | B.B. | C. WHITLOCK | 10/25/2024 | |
| <p>THESE DRAWINGS AND REVISIONS ARE INSTRUMENTS OF SERVICE. THE DRAWINGS AND ASSOCIATED COPIES THEREOF, INCLUDING ELECTRONIC MEDIA AND CAD FILES, ARE THE PROPERTY OF ARCHITECTS LEWIS + WHITLOCK P.A.A. THEIR USE, REPRESENTATION OR REPRODUCTION FOR ANY PURPOSE EXCEPT BY WRITTEN AGREEMENT WITH THE ARCHITECT IS PROHIBITED. THIS COPYRIGHT NOTIFICATION SHALL BE TRUE AS IF DIRECTLY PLACED ON EACH DRAWING EXHIBIT. UPON EXPIRATION OF THIS DOCUMENT AND SHALL BE REMOVED FROM THESE DOCUMENTS</p> | |







Architects Lewis + Whitlock
206 West Virginia St.
Tallahassee, Florida 32301
850.942.1718
www.think3d.net

Description:
**Demolition Roof
Plan**

Sheet No.:

D1.1

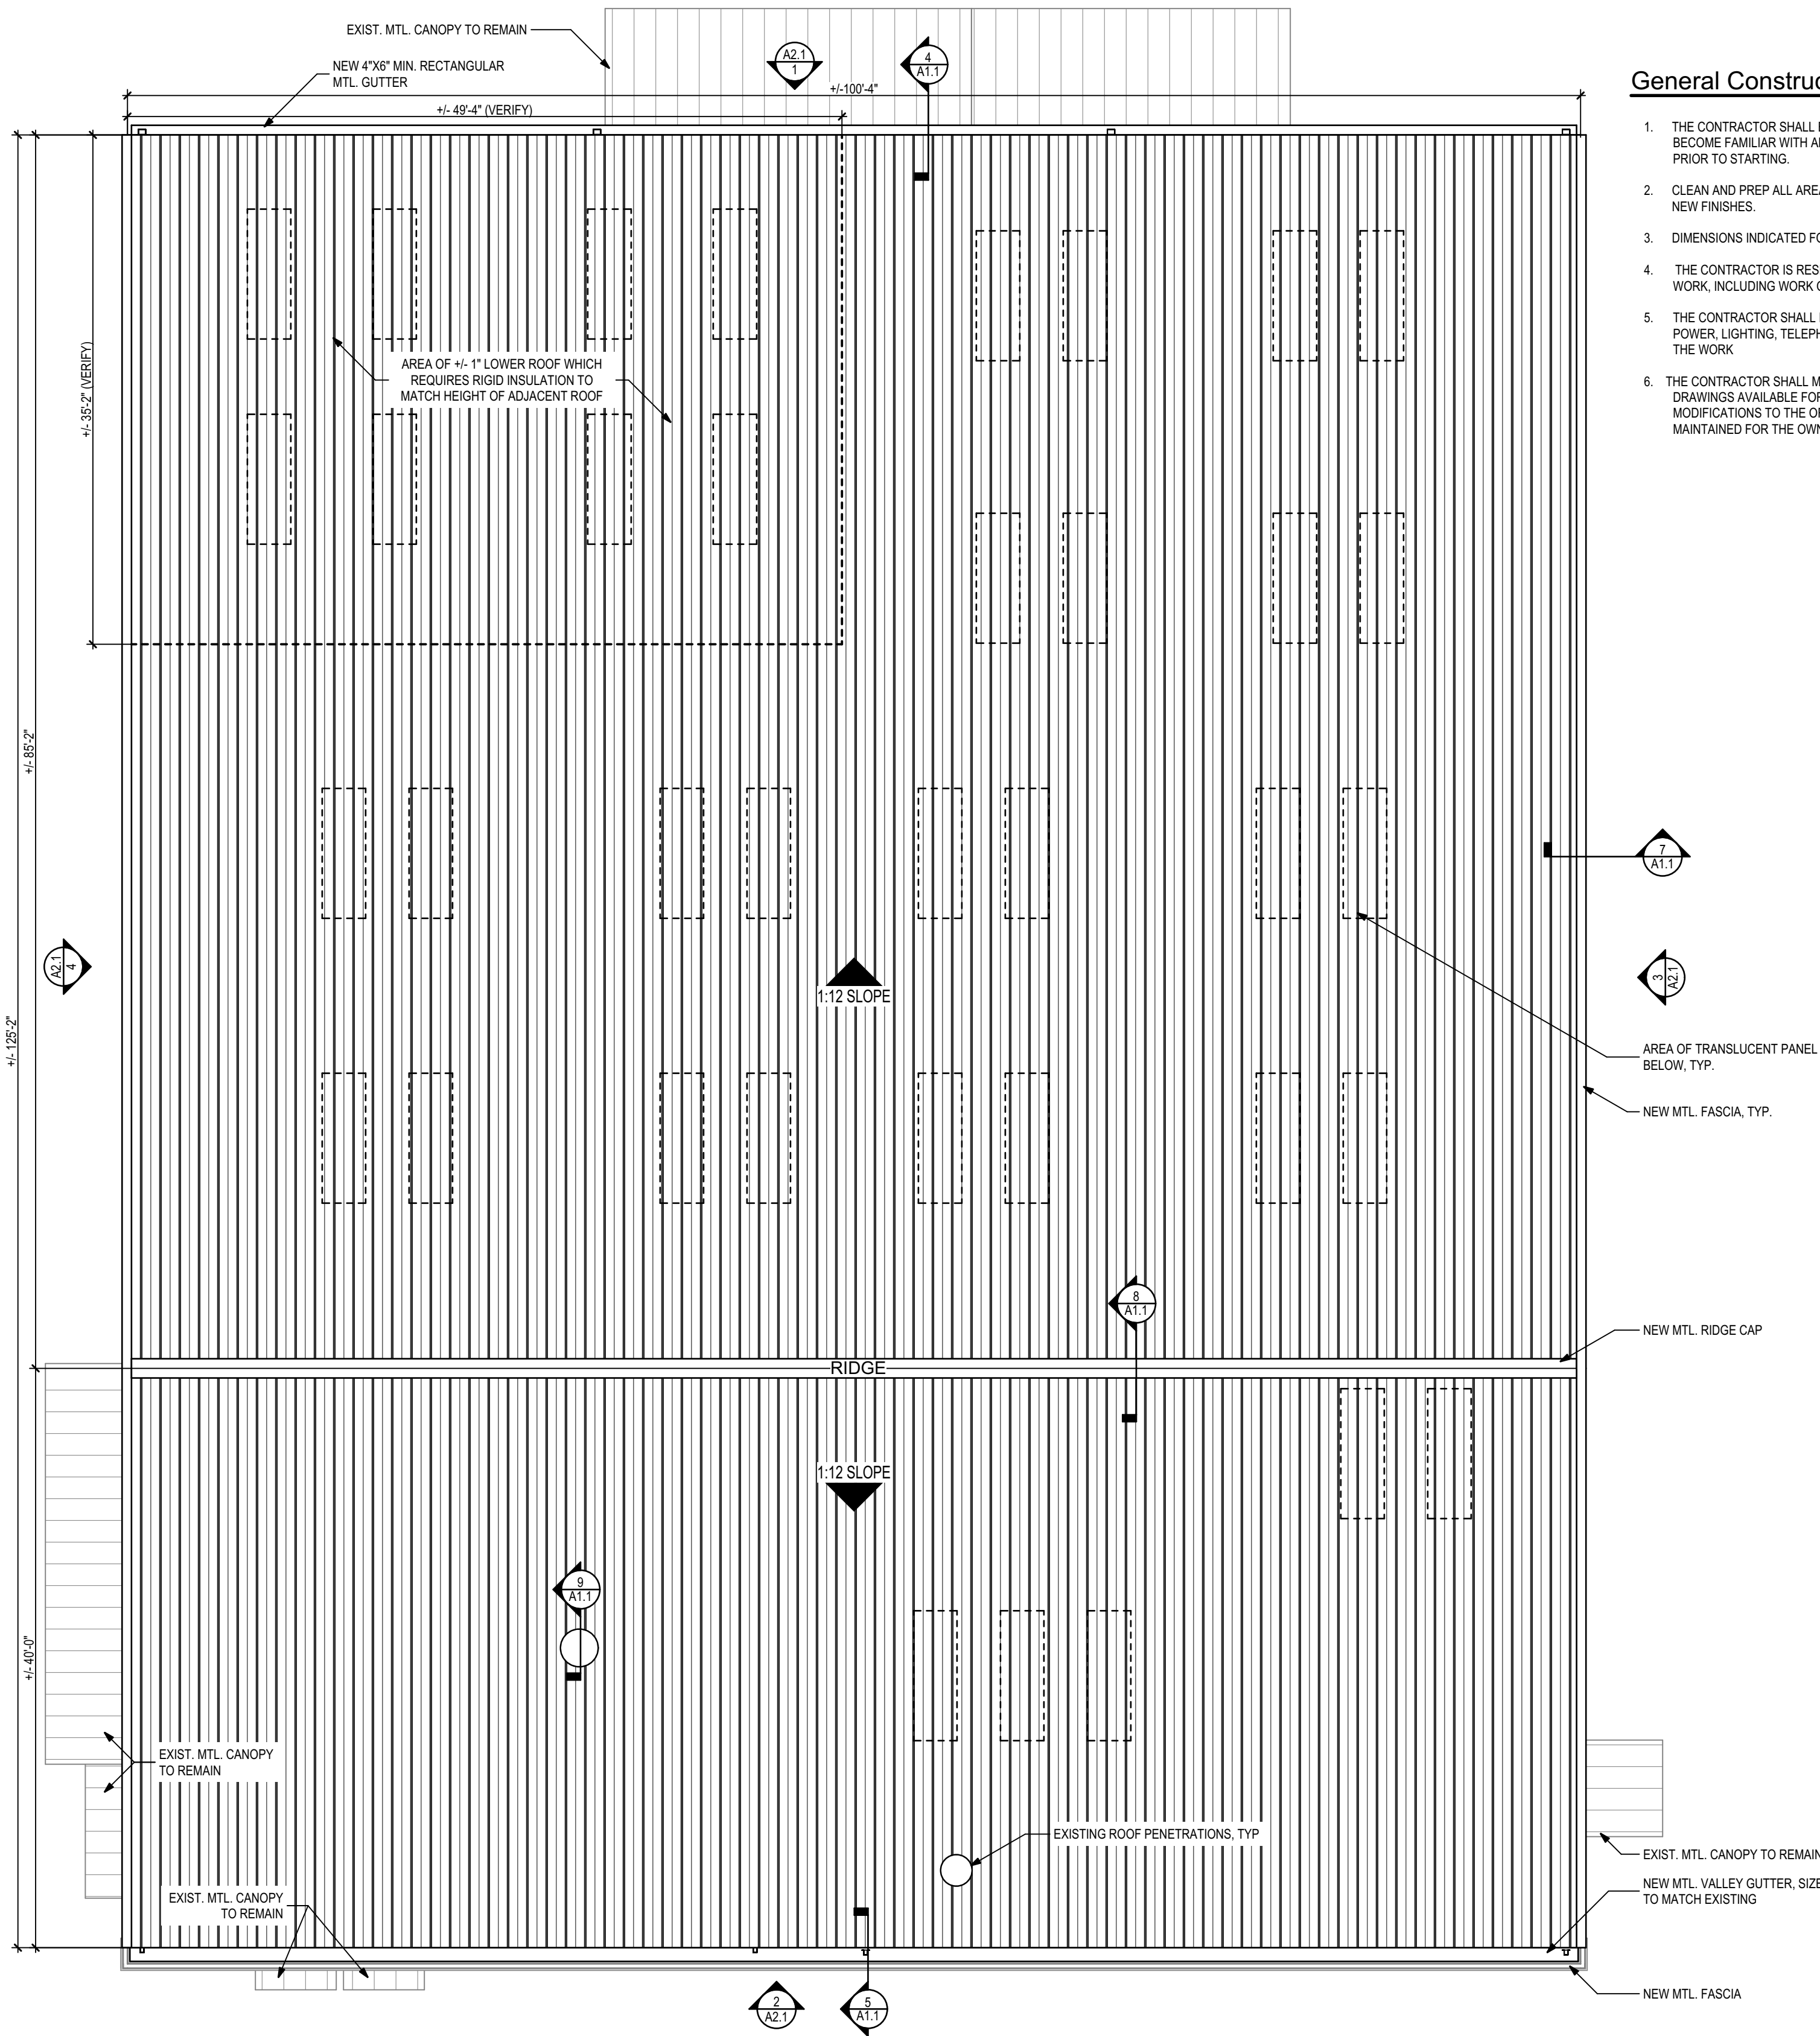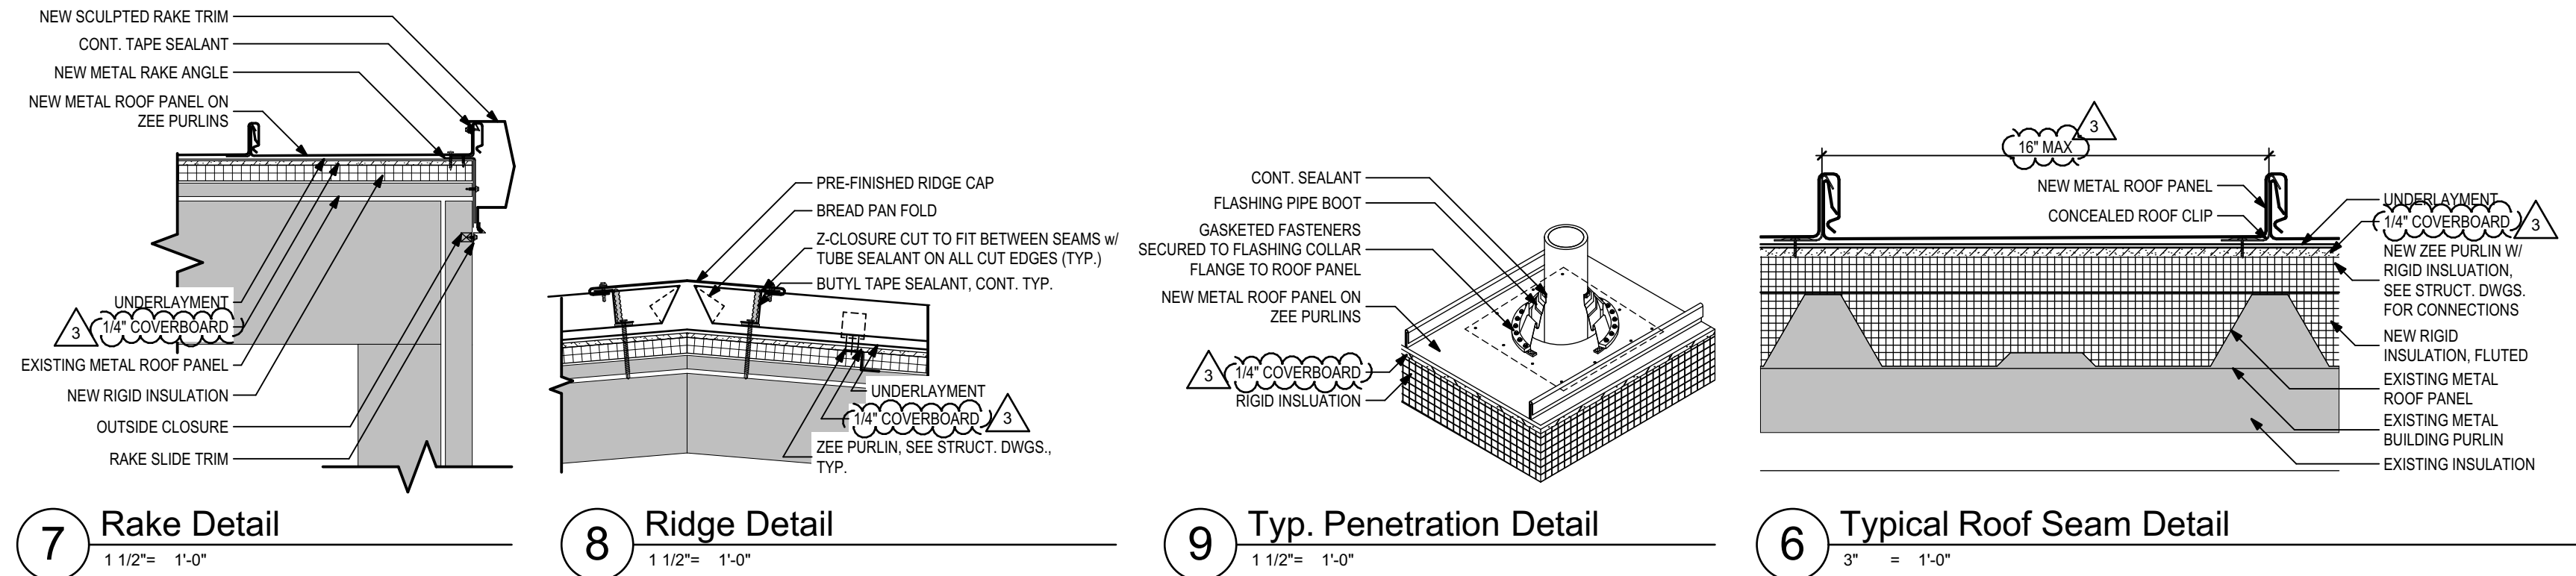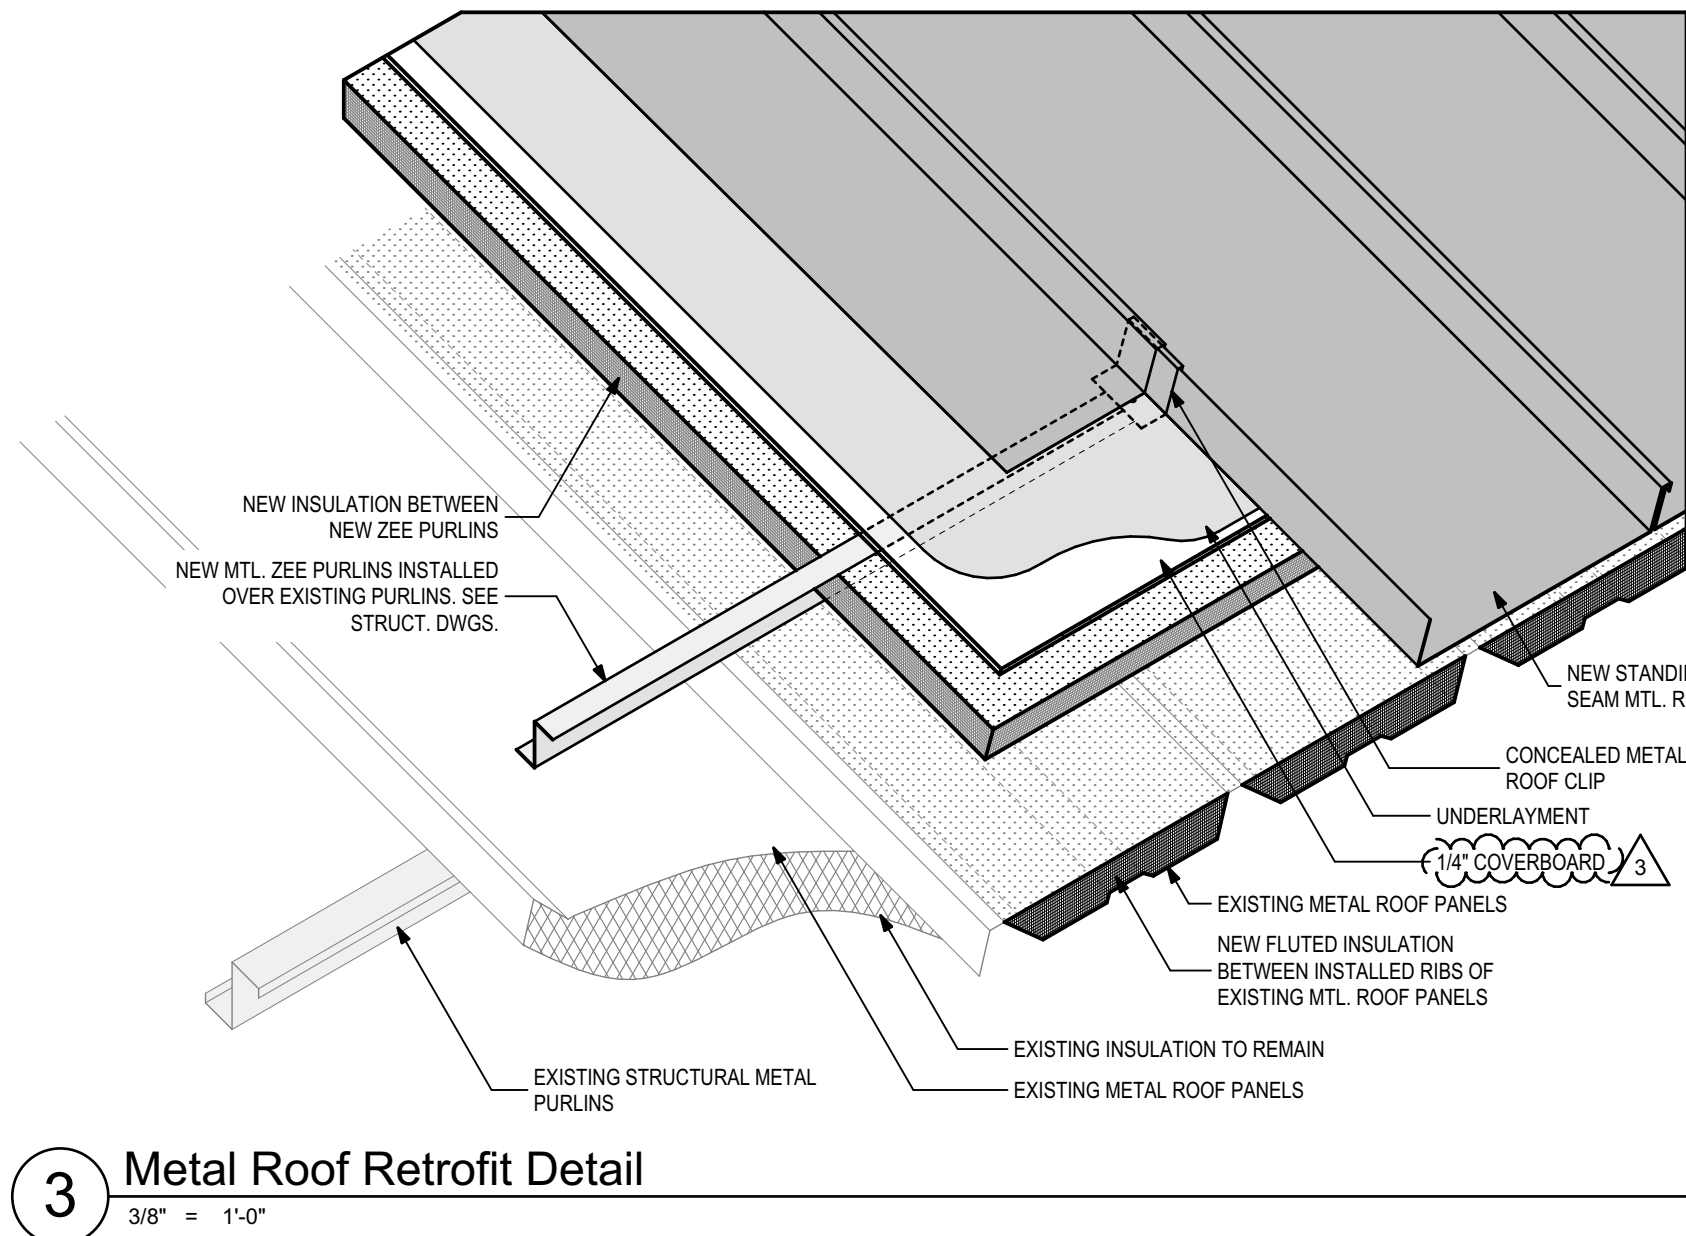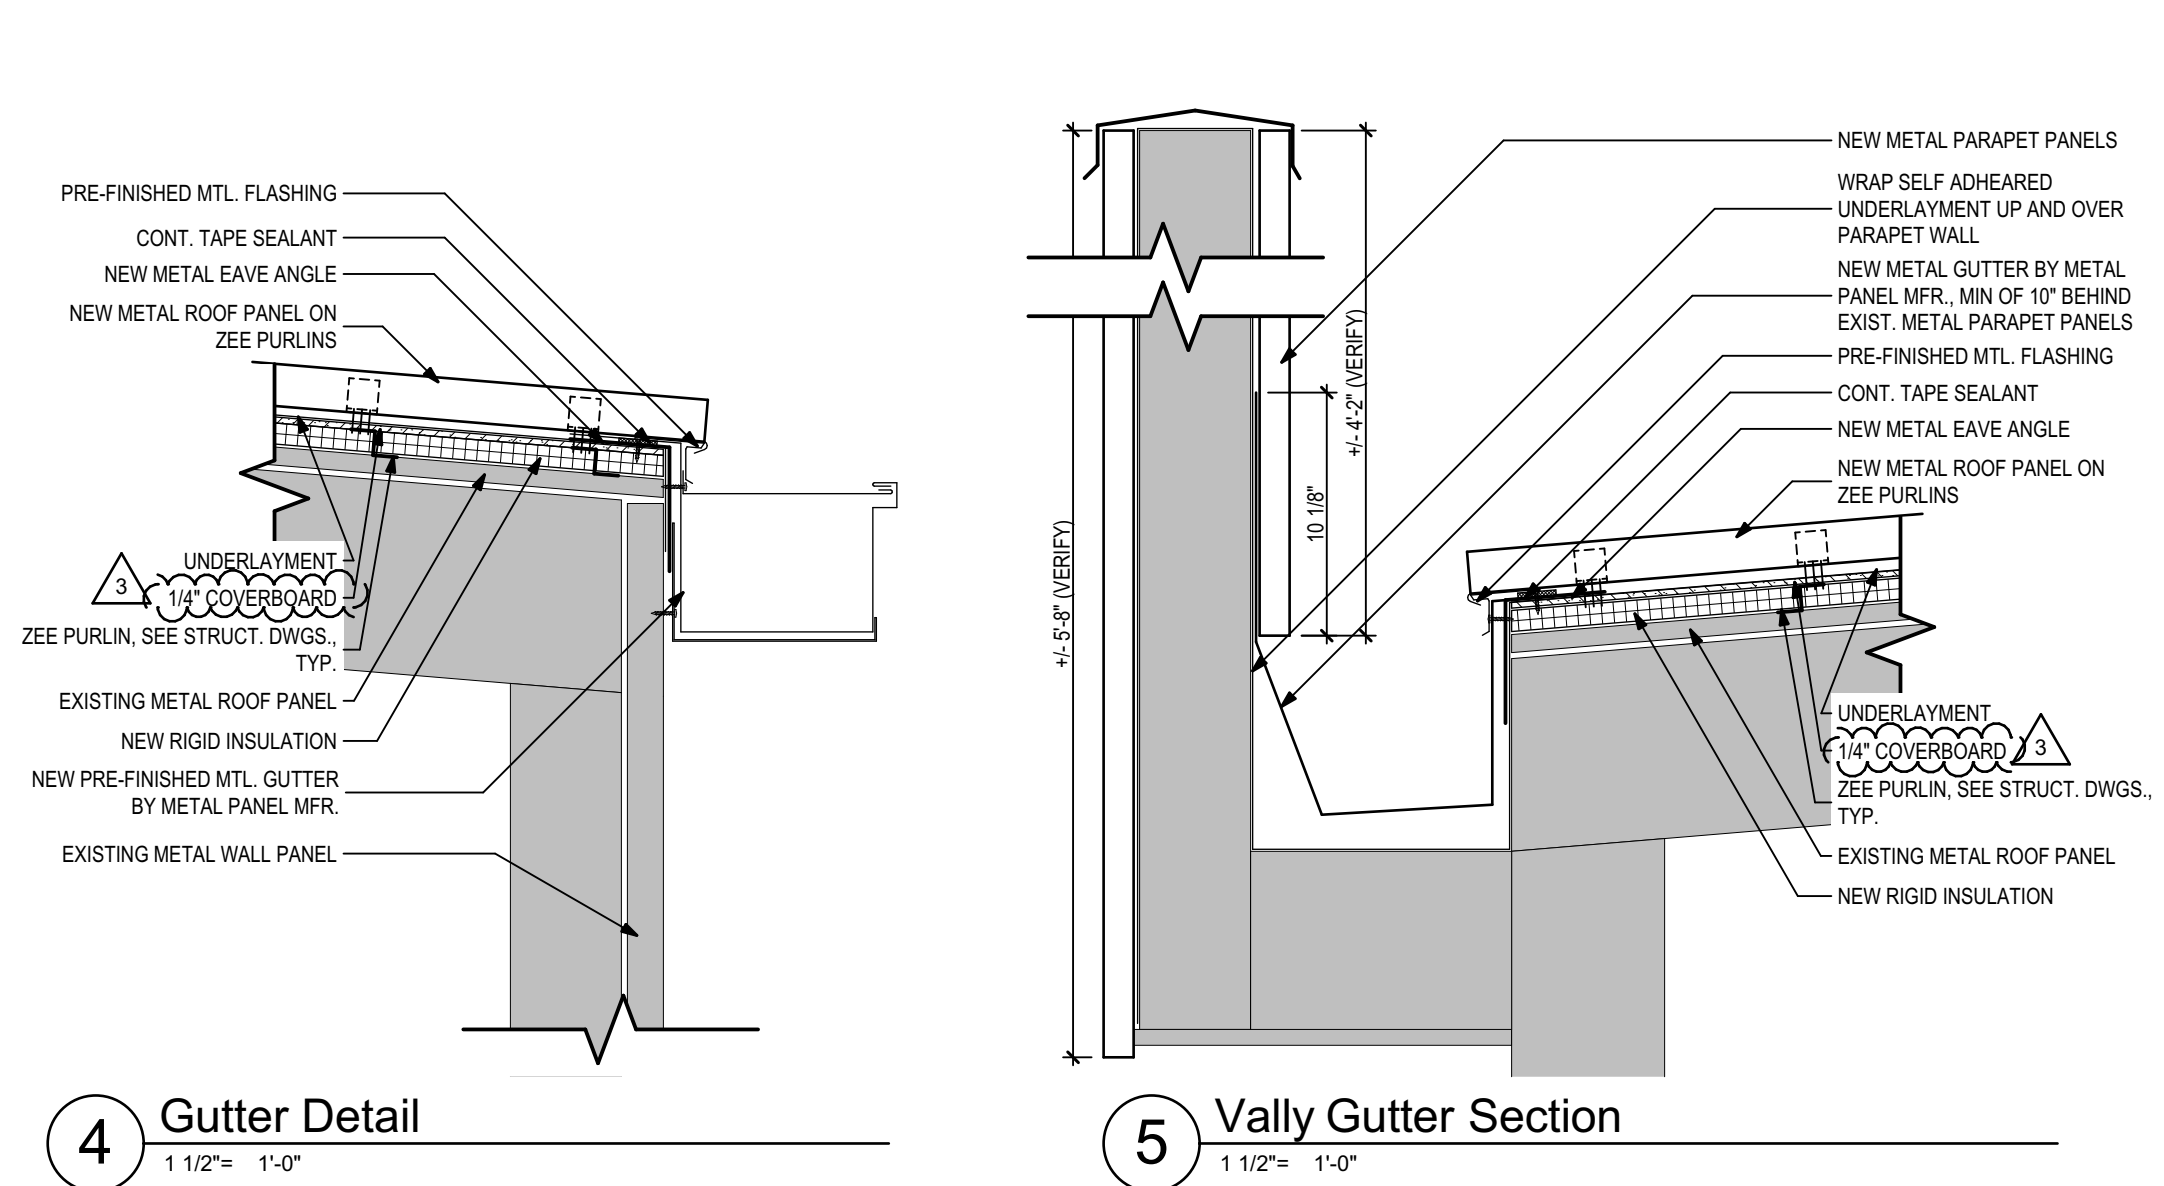

General Construction Notes

1. THE CONTRACTOR SHALL EXAMINE THE SITE AND EXISTING CONDITIONS AND BECOME FAMILIAR WITH ALL CONDITIONS WHICH MAY AFFECT THE WORK, PRIOR TO STARTING.
2. CLEAN AND PREP ALL AREAS WITHIN SCOPE OF WORK TO RECEIVE NEW FINISHES.
3. DIMENSIONS INDICATED FOR EX. CONSTRUCTION ARE ACCURATE TO +/- 1".
4. THE CONTRACTOR IS RESPONSIBLE FOR COORDINATION OF ALL TRADES AND WORK, INCLUDING WORK OF OTHERS WHERE AFFECTED.
5. THE CONTRACTOR SHALL PROVIDE BARRICADES, DUST CONTROL, TEMPORARY POWER, LIGHTING, TELEPHONE SERVICE, ETC. AS REQUIRED TO COMPLETE THE WORK.
6. THE CONTRACTOR SHALL MAINTAIN A FULL SET OF COMPLETE AND CURRENT DRAWINGS AVAILABLE FOR REVIEW AT THE JOB SITE AT ALL TIMES. ALL FIELD MODIFICATIONS TO THE ORIGINAL DESIGN DOCUMENTS SHALL BE NOTED AND MAINTAINED FOR THE OWNER'S RECORD COPY.

Drawing Legend

| | |
|--|---------------------------------|
| | EXISTING METAL ROOF TO REMAIN |
| | EXISTING CONSTRUCTION TO REMAIN |
| | NEW METAL ROOF |
| | NEW METAL FLASHING |
| | CONSTRUCTION ABOVE |
| | CONSTRUCTION BELOW |

| PHASE: | DRAWN: | REVIEWED: | DATE: | ID: | REVISION: | DRAWN: | REVIEWED: | DATE: |
|-------------------------|--------|-------------|------------|-----|-----------|--------|-----------|-------|
| CONCEPT SCHEM. DESIGN | | B.B. | 2/25/2025 | 1 | 1 | | | |
| ADVANCED SCHEM. DESIGN | | B.B. | 2/27/2025 | 2 | 2 | | | |
| 50% CONSTRUCTION DOCS. | | B.B. | 2/27/2025 | 3 | 3 | | | |
| 80% CONSTRUCTION DOCS. | | B.B. | 2/27/2025 | | | | | |
| PERMIT DOCS. | | B.B. | 2/27/2025 | | | | | |
| 100% CONSTRUCTION DOCS. | | B.B. | 2/27/2025 | | | | | |
| | | C. WHITLOCK | 10/25/2024 | | | | | |

Client:

Leon County Schools
3420 W. Tharpe St., Suite 100
Tallahassee, FL 32303

Consultant:

Architects Lewis + Whitlock
206 West Virginia St.
Tallahassee, Florida 32301
850.942.1718
www.think3d.net

Project #:

24510.1

Phase:

100% Construction Documents

Job Title:

LCS Athletics Maintenance Building
No. 3 Re-Roofing

Description:


Roof Plan & Details

Sheet No.:


A1.1




Architects Lewis + Whitlock
206 West Virginia St.
Tallahassee, Florida 32301
850.942.1718
www.think3d.net

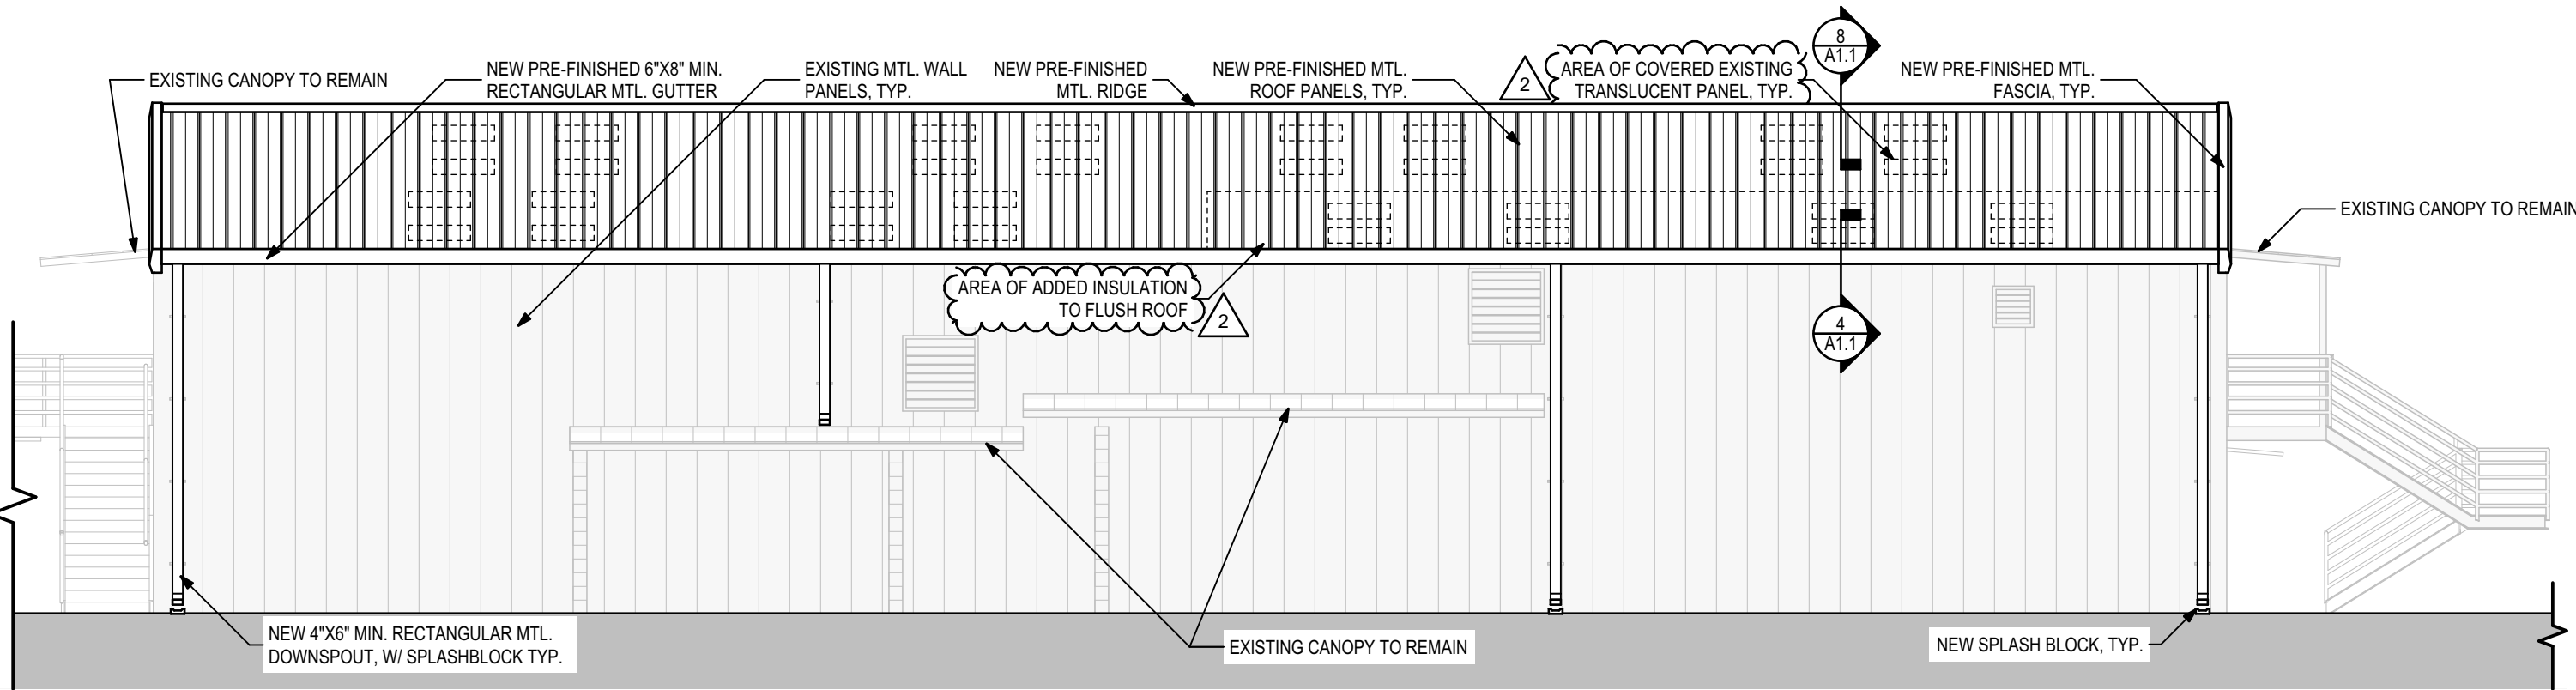


1 South Elevation
1/8" = 1'-0"

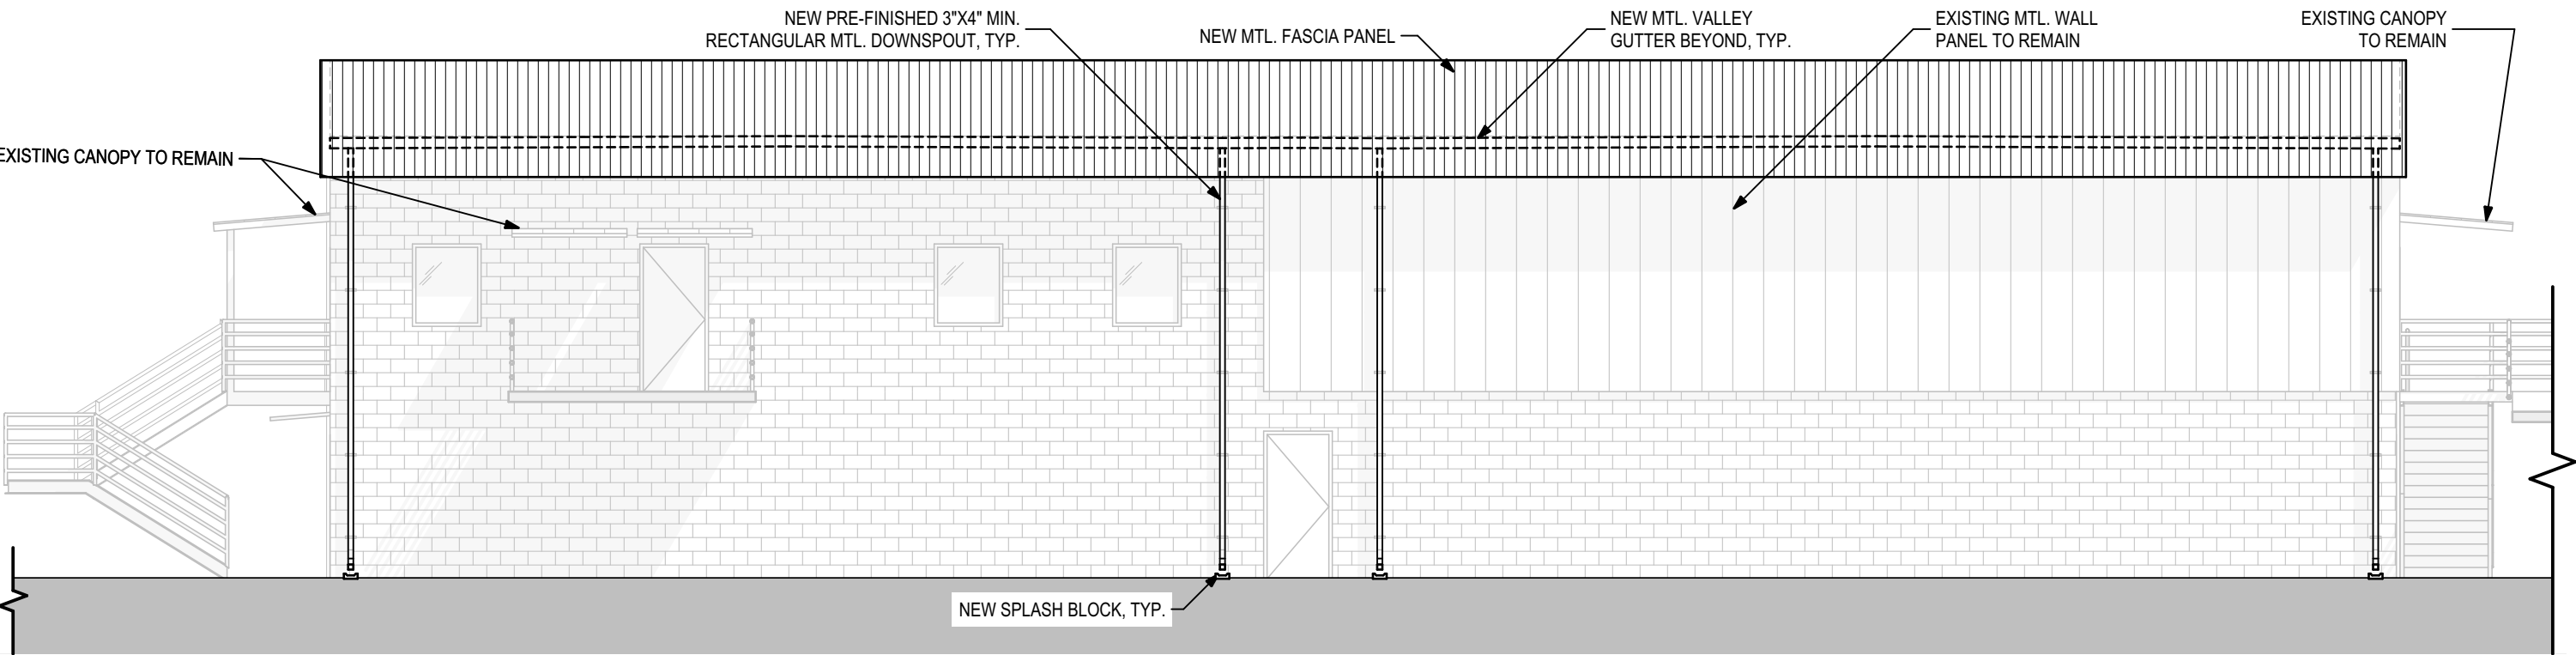

2 North Elevation
1/8" = 1'-0"

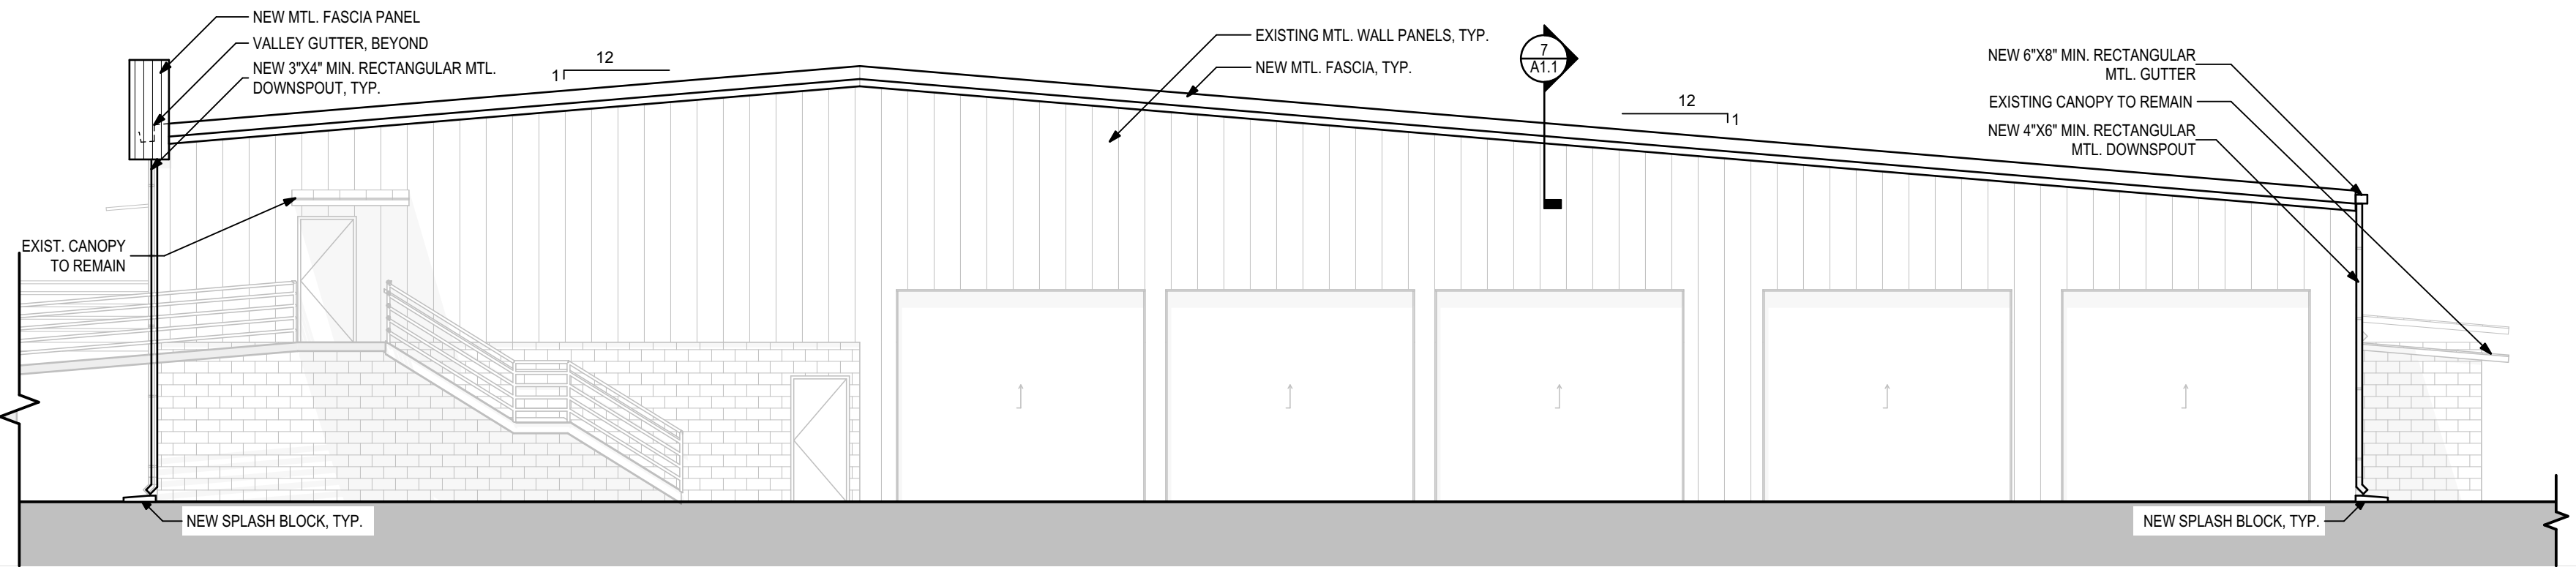


3 West Elevation
1/8" = 1'-0"

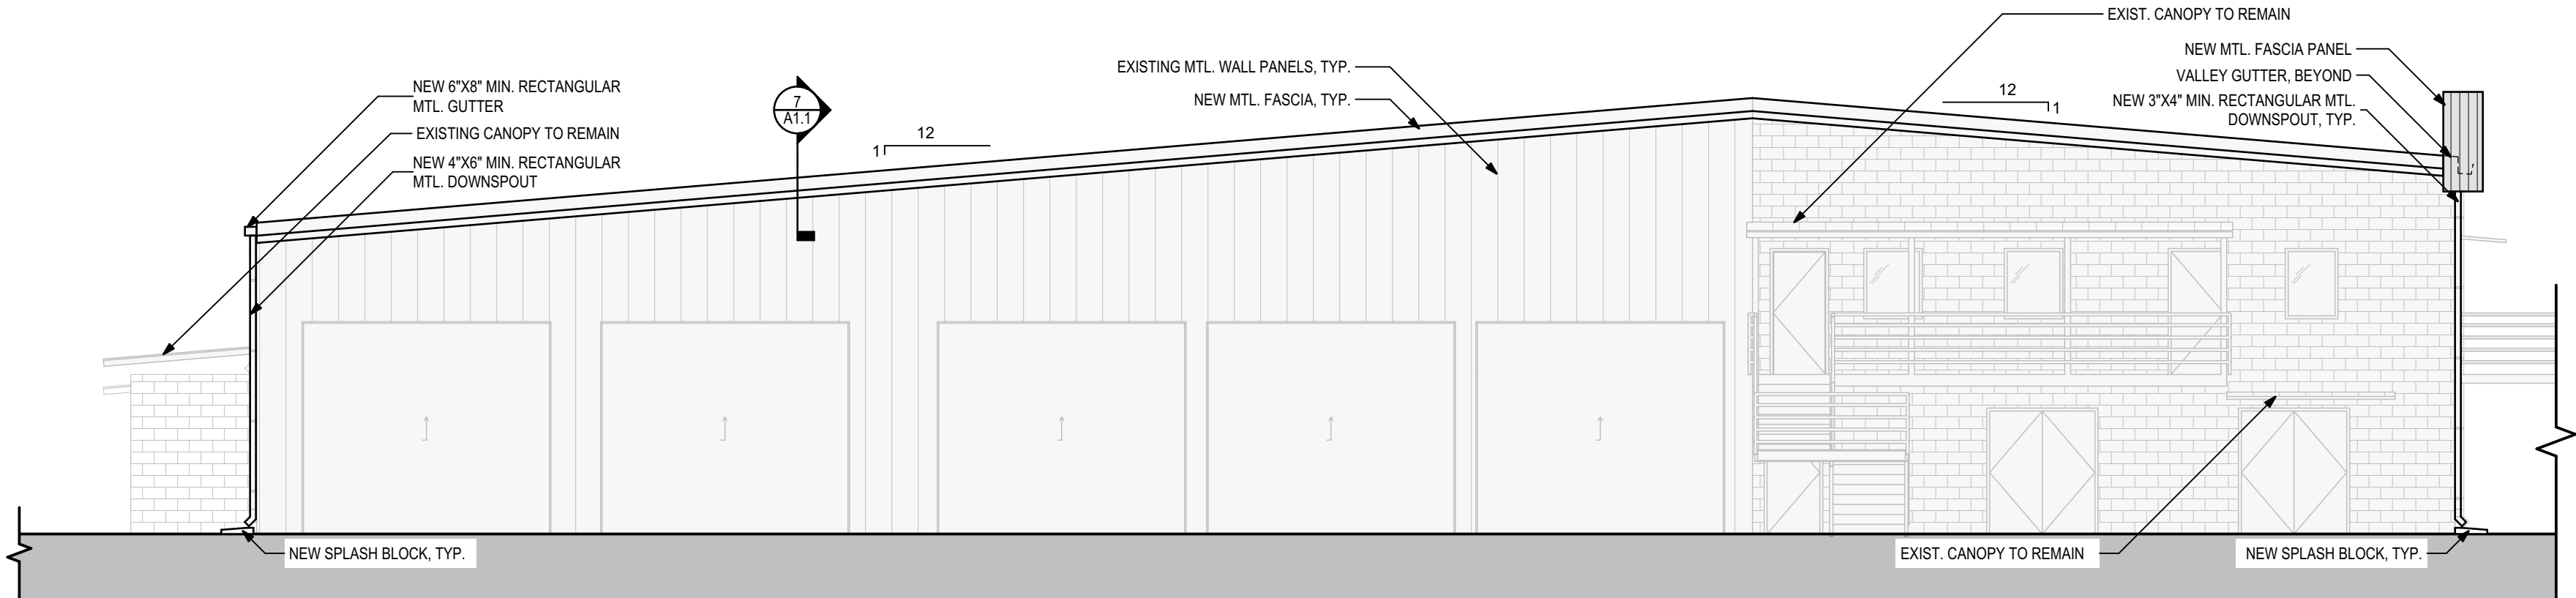

4 East Elevation
1/8" = 1'-0"

| PHASE: | DRAWN: | REVIEWED: | DATE: | ID: | REVISION: | DRAWN: | REVIEWED: | DATE: |
|-------------------------|--------|-------------|------------|-----|----------------|--------|-----------|-------|
| CONCEPT SCHEM. DESIGN | | | | 1 | Addendum No. 1 | | | |
| ADVANCED SCHEM. DESIGN | | | | 2 | Addendum No. 2 | | | |
| 50% CONSTRUCTION DOCS. | | | | | | | | |
| 80% CONSTRUCTION DOCS. | | | | | | | | |
| PERMIT DOCS. | | | | | | | | |
| 100% CONSTRUCTION DOCS. | B.B. | C. WHITLOCK | 10/25/2024 | | | | | |

| | | | | | |
|---|--|---|--|--|--|
|  | | Leon County Schools 3420 W. Tharpe St., Suite 100 Tallahassee, FL 32303 | | LCS Athletics Maintenance Building No. 3 Re-Roofing | |
| Client: | | | | Job Title: | |
| Consultant: | | | | Project #: | |
| Seal: | | | | Phase: | |
| | | 24510.1 | | 100% Construction Documents | |

ALW
Architects Lewis + Whitlock
206 West Virginia St.
Tallahassee, Florida 32301
850.942.1718
www.think3d.net

Description:
Exterior Elevations

Sheet No.:
A2.1

1. GENERAL NOTES

- THE GOVERNING CODE FOR THIS PROJECT IS THE FLORIDA BUILDING CODE 8th EDITION (2023). THIS CODE PRESCRIBES WHICH EDITION OF EACH REFERENCE STANDARD APPLIES TO THIS PROJECT, UNLESS OTHERWISE NOTED. ALL WORK AND MATERIALS SHALL CONFORM WITH THE GOVERNING BUILDING CODE AND ALL OTHER APPLICABLE FEDERAL, STATE AND LOCAL CODES, STANDARDS, REGULATIONS AND LAWS.
- THE CONTRACTOR SHALL COORDINATE ALL CONTRACT DOCUMENTS WITH FIELD CONDITIONS, DIMENSIONS, AND PROJECT SHOP DRAWINGS PRIOR TO CONSTRUCTION. DO NOT SCALE DRAWINGS. USE ONLY PRINTED DIMENSIONS. REPORT ANY DISCREPANCIES OR FIELD CONDITIONS ENCOUNTERED IN CONFLICT WITH THE DRAWINGS IN WRITING TO THE ARCHITECT AND/OR ENGINEER PRIOR TO PROCEEDING WITH WORK. DO NOT CHANGE SIZE OR LOCATION OF STRUCTURAL MEMBERS WITHOUT WRITTEN INSTRUCTIONS FROM THE ARCHITECT OR ENGINEER OF RECORD.
- THE STRUCTURE SHOWN ON THESE DRAWINGS IS SELF-SUPPORTING ONLY IN ITS COMPLETED FORM. THE DESIGN, ADEQUACY, SAFETY AND STABILITY OR ERECTION BRACING, FORMWORK, SHORING, AND TEMPORARY SUPPORTS ARE THE SOLE RESPONSIBILITY OF THE CONTRACTOR.
- DETAILS LABELED AS "TYPICAL" APPLY TO ALL SITUATIONS THAT ARE THE SAME OR SIMILAR TO THOSE SPECIFICALLY REFERENCED, WHETHER OR NOT THEY ARE KEYED IN AT EACH LOCATION.
- THE CONTRACTOR SHALL PROTECT ADJACENT PROPERTY, HIS OWN WORK, AND THE GENERAL PUBLIC FROM HARM. THE CONTRACTOR IS SOLELY RESPONSIBLE FOR CONSTRUCTION MEANS AND METHODS, AND JOBSITE SAFETY INCLUDING ALL OSHA REQUIREMENTS. THE STRUCTURAL ENGINEER OF RECORD HAS NO AUTHORITY TO EXERCISE ANY CONTROL OVER ANY CONSTRUCTION PERSONNEL RELATED TO THEIR WORK OR ANY HEALTH OR SAFETY PRECAUTIONS.

2. SHOP DRAWING SUBMITTAL & REVIEW

- SHOP DRAWINGS ARE REQUIRED FOR THE FOLLOWING ITEMS, AT A MINIMUM:
LIGHT GAUGE METAL FRAMING
- ALL SUBMISSIONS OF SHOP DRAWINGS FOR REVIEW SHALL BE MADE ELECTRONICALLY.
- ALLOW TEN (10) WORKING DAYS FOR REVIEW OF EACH SHOP DRAWING COMMENCING THE NEXT WORKING DAY AFTER RECEIPT. CONTRACTOR SHALL PLAN SCHEDULE ACCORDINGLY TO ACCOMMODATE THIS REVIEW TIME.
- SHOP DRAWINGS REVIEW IS FOR GENERAL CONFORMANCE WITH THE DESIGN CONCEPT. CORRECTIONS OR COMMENTS MADE ON THIS REVIEW DO NOT RELIEVE THE CONTRACTOR OF RESPONSIBILITY FOR ERRORS AND OMISSIONS, NOR FROM COMPLIANCE WITH THE PLANS AND SPECIFICATIONS. CORRECTIONS OR COMMENTS DO NOT AUTHORIZE AN INCREASE IN THE CONSTRUCTION BUDGET.
- REVIEW OF SHOP DRAWINGS DOES NOT CONSTITUTE ACCEPTANCE OF DEVIATIONS FROM CONTRACT DOCUMENTS OR PREVIOUS SHOP DRAWING REVIEW COMMENTS UNLESS SPECIFICALLY NOTED THEREIN BY THE ENGINEER OF RECORD.
- CONTRACTOR RESPONSIBILITIES PRIOR TO SUBMITTING A SHOP DRAWING OR ANY RELATED MATERIAL TO THE ENGINEER:
 - REVIEW EACH SUCH SUBMISSION FOR CONFORMANCE WITH THE MEANS, METHODS, TECHNIQUES, SEQUENCES AND OPERATIONS OF CONSTRUCTION, AND SAFETY PRECAUTIONS AND PROGRAMS INCIDENTAL THERETO WHICH ARE SOLELY THE RESPONSIBILITY OF THE CONTRACTOR.
 - REVIEW AND APPROVE EACH SET PRIOR TO SUBMISSION WHICH SHALL INCLUDE VERIFICATION OF ALL DIMENSIONS AND GENERAL CONFORMANCE WITH THE CONSTRUCTION DOCUMENTS.
- THE CONTRACTOR IS FULLY RESPONSIBLE FOR ANY AND ALL CHANGES OR DELAYS CAUSED BY SUBMITTING INCOMPLETE SHOP DRAWINGS AND SHALL NOT BEGIN CONSTRUCTION OR FABRICATION WITHOUT RECEIPT OF REVIEWED SHOP DRAWINGS.


3. DESIGN LOADS

| | |
|------|---------------------|
| ROOF | LIVE LOAD 20 PSF |
|------|---------------------|

4. WIND LOAD DESIGN CRITERIA (PER ASCE 7-22)

| | |
|--------------------------|--------------------|
| WIND SPEED (ULT/ASD) | = 120 MPH / 93 MPH |
| RISK CATEGORY | = II |
| WIND EXPOSURE CATEGORY | = B |
| ENCLOSURE CLASSIFICATION | = ENCLOSED |

SEE CLADDING DIAGRAM (THIS SHEET FOR COMPONENTS AND CLADDING LOADING)

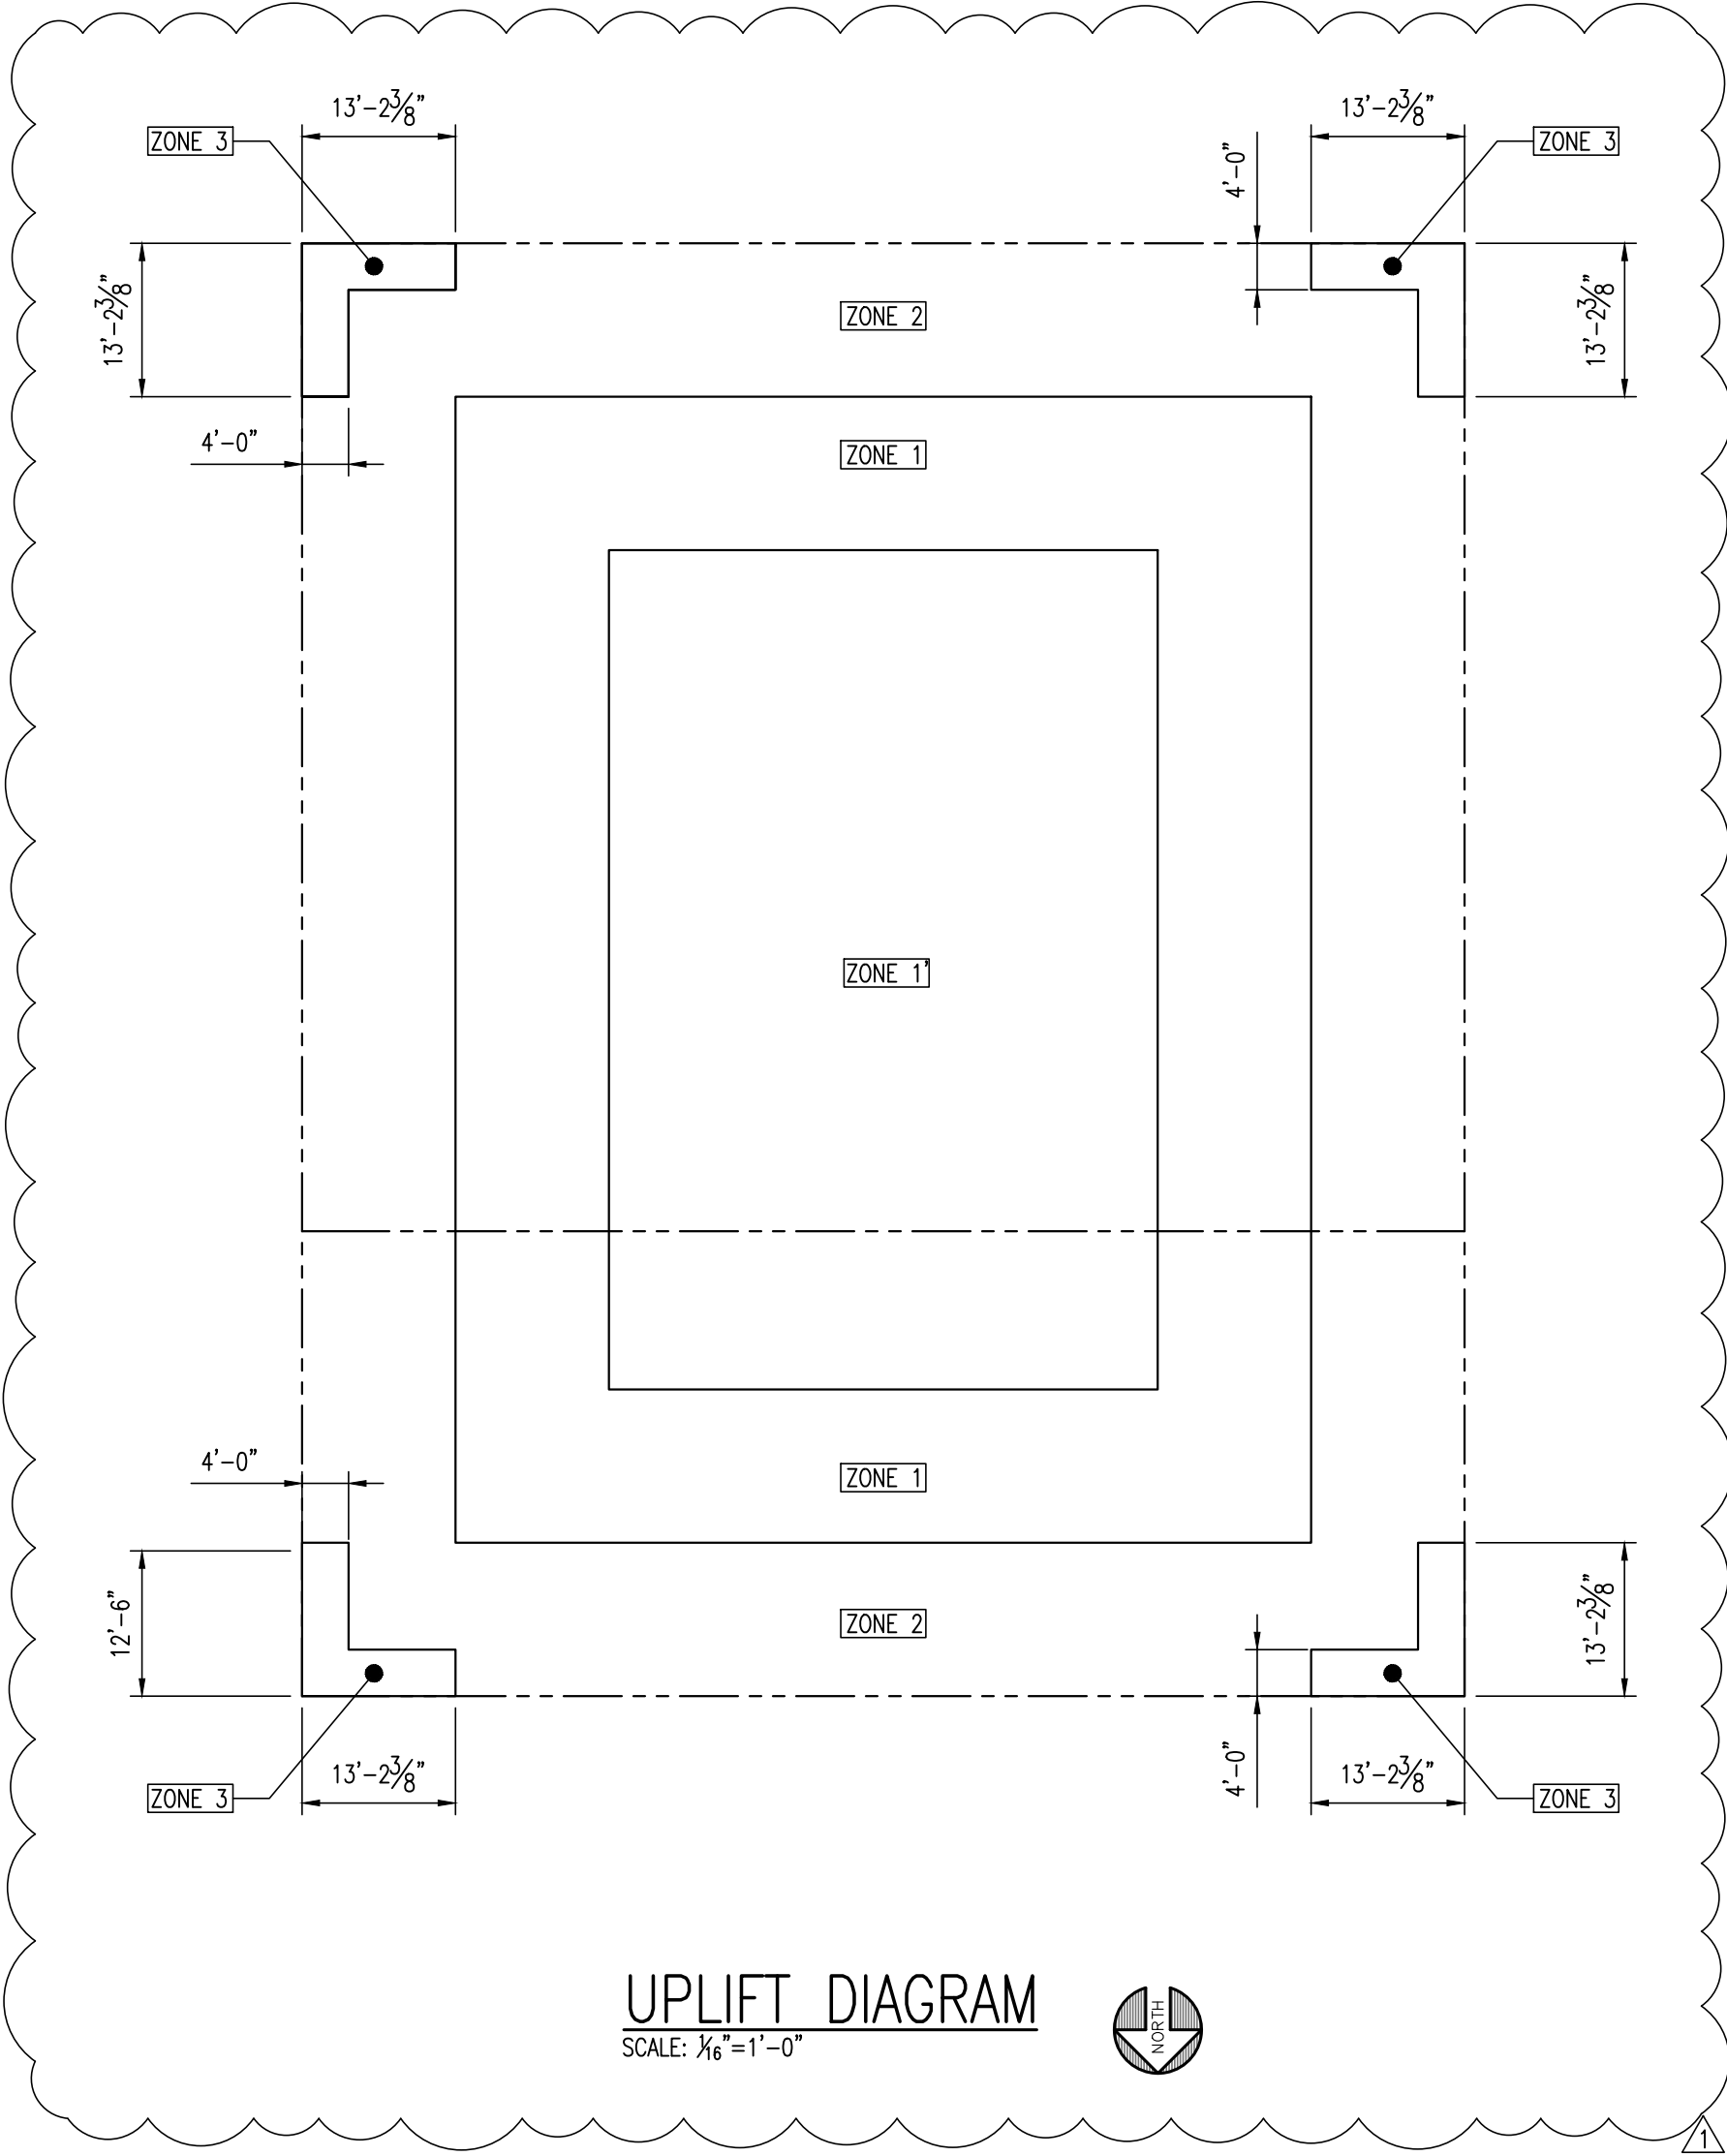


UPLIFT DIAGRAM

5. STRUCTURAL STEEL

- FABRICATE AND ERECT STRUCTURAL STEEL IN CONFORMANCE, W/ AISC "SPECIFICATION FOR THE DESIGN, FABRICATION AND ERECTION OF STRUCTURAL STEEL FOR BUILDINGS", WITH COMMENTARY, AND ALL OSHA REQUIREMENTS.
- STRUCTURAL STEEL SHAPES SHALL BE FABRICATED FROM THE FOLLOWING MATERIALS:
 - ROLLED W AND WT SHAPES: ASTM A992, GRADE 50.
 - ROLLED M, S, C AND MC SHAPES AND ANGLES: ASTM A36, Fy=36 KSI.
 - PLATES AND BARS: ASTM A36, Fy=36 KSI.
 - STEEL PIPE: ASTM A53, GRADE B, Fy=35 KSI.
 - COLD-FORMED HOLLOW STRUCTURAL SECTIONS (HSS):
SQUARE AND RECTANGULAR SECTIONS: ASTM A500, GRADE C, Fy=50 KSI.
ROUND SECTIONS: ASTM A500, GRADE C, Fy=46 KSI.
- ALL SHOP AND FIELD WELDING SHALL CONFORM TO THE AWS D1.1 STRUCTURAL WELDING CODE BY THE AMERICAN WELDING SOCIETY. USE E70 SERIES WELDING ELECTRODES, U.O.N. WHERE NECESSARY, REMOVE GALVANIZING OR PRIMER PRIOR TO WELDING.
- ALL ANCHOR BOLTS SHALL BE ASTM F1554-36, U.N.O.
- A325 BOLTS SHALL COMPLY WITH "SPECIFICATION FOR STRUCTURAL JOINTS USING: ASTM A325 OR A490 BOLTS", INCLUDING COMMENTARY.
- TYPICAL BOLTS USED IN STRUCTURAL CONNECTIONS FOR THIS PROJECT ARE 3/4 INCH DIAMETER, U.O.N.
- COLD-FORMED STEEL FRAMING
 - ALL COLD-FORMED STEEL FRAMING SHALL CONFORM TO ASTM A1003 AND BE FABRICATED AND ERECTED IN ACCORDANCE WITH MANUFACTURER'S RECOMMENDATIONS AND WITH THE LATEST EDITION OF "SPECIFICATIONS FOR THE DESIGN OF COLD-FORMED STEEL STRUCTURAL MEMBERS" BY THE AMERICAN IRON AND STEEL INSTITUTE (AISI).
 - COLD-FORMED STEEL FRAMING SHOWN SHALL HAVE THE FOLLOWING MINIMUM MATERIAL PROPERTIES:
 - 16 GAUGE (54 MIL) AND THICKER SHALL HAVE A MINIMUM YIELD STRESS OF Fy = 50 KSI AND A TENSILE STRENGTH OF Fu = 65 KSI.
 - 18 GAUGE (43 MIL) AND THINNER SHALL HAVE A MINIMUM YIELD STRESS OF Fy = 33 KSI AND A TENSILE STRENGTH OF Fu = 45 KSI.
- USE GALVANIZED (G60) STEEL "C" STUDS, TRACKS, ANGLES AND STRAPS AS SHOWN ON DRAWINGS. ALL STUDS SHALL HAVE A MINIMUM FLANGE WIDTH OF 1-5/8 INCH WITH A 1/2 INCH RETURN LIP. TRACKS SHALL BE A MINIMUM OF THE SAME GAUGE AS STUDS WITH MINIMUM OF 1-1/4 INCH LEG.
- MAXIMUM SPACING OF LATERAL BRIDGING FOR COLD-FORMED STEEL STUDS SHALL BE 4 FEET FOR SPANS GREATER THAN 10 FEET AND MIDSPAN FOR SHORTER SPANS. LATERAL BRIDGING SHALL ALSO BE PROVIDED AT FREE ENDS OF CANTILEVERED PARAPETS AND NEAR THE SUPPORTS OF CONTINUOUS SPANS.
- STUDS SHALL BE FREE OF KINKS AND TWISTS AND SHALL BE SECURELY SEATED FOR FULL END BEARING ON TOP AND BOTTOM TRACK.
- UNLESS INDICATED OTHERWISE, PROVIDE DOUBLE STUDS AT ALL JAMBS, CORNERS AND INTERSECTIONS.
- LIGHT GAUGE FRAMING (LGF) SHALL BE CONNECTED, AT A MINIMUM, AS FOLLOWS:
LGF TO STEEL:
TRACKS - 1 PAF @ 12" O.C. STAGGERED
CLIPS - 2 PAF
LGF TO CONCRETE:
TRACKS - 1 PAF @ 12" O.C. STAGGERED
CLIPS - 2 PAF
LGF TO LGF:
TRACKS - #10 TO EACH FLANGE
CLIPS/STUD - 4 #10
- SCREWS, WHERE REQUIRED, SHALL MEET THE MINIMUM REQUIREMENTS OF SAE J-429 GRADE 5 AND IFI-105. SCREWS SHALL HAVE A PROTECTIVE COATING EQUIVALENT TO CADMIUM OR ZINC PLATING, ASTM B766.
- POWDER ACTUATED FASTENERS (PAF) SHALL BE HILTI X-U KNURLED SHANK FASTENERS (WITH A MINIMUM SHANK DIAMETER OF 0.157 INCHES) OR APPROVED EQUAL. A MINIMUM EMBEDMENT OF 1 INCH SHALL BE PROVIDED FOR ALL CONCRETE CONNECTIONS.
- #12 SELF TAPPING SCREWS MAY BE USED IN LIEU OF THE SPECIFIED PAF FOR CONNECTIONS OF LIGHT GAUGE FRAMING TO STEEL AT THE SPACINGS SHOWN ABOVE FOR PAF IF THE THICKNESS OF THE STRUCTURAL STEEL ALLOWS FOR PROPER INSTALLATION.
- FIELD CUTTING OF LIGHT GAUGE FRAMING MEMBERS SHALL BE BY SAW OR SHEAR. TORCH CUTTING IS NOT PERMITTED.
- SPLICING OF FRAMING COMPONENTS, OTHER THAN THE CONTINUOUS TRACK AT THE TOP AND BOTTOM OF WALLS, IS NOT PERMITTED, U.O.N. SPLICING OF TRACK USED IN THE CONSTRUCTION OF THE JAMB, HEAD OR SILL ASSEMBLIES OF FRAMED WALL OPENINGS IS NOT PERMITTED. WHERE SPLICING OF TRACK IS NECESSARY BETWEEN STUD SPACINGS, A SECTION OF STUD SHALL BE PLACED IN THE ADJOINING TRACKS ACROSS THE JOINT AND FASTENED TO THE FLANGES AT BOTH SIDES OF THE WALL.

| COMPONENT & CLADDING LOADS - ROOF | | |
|-----------------------------------|------------------------|------------|
| TRIB AREA | PRESSURE | |
| ZONE (1') | ROOF - INTERIOR | |
| | 10 SQ. FT. | 16.0 -23.7 |
| | 20 SQ. FT. | 16.0 -23.7 |
| | 50 SQ. FT. | 16.0 -23.7 |
| | 100 SQ. FT. | 16.0 -23.7 |
| ZONE (1) | ROOF - INTERIOR | |
| | 10 SQ. FT. | 16.0 -41.2 |
| | 20 SQ. FT. | 16.0 -38.5 |
| | 50 SQ. FT. | 16.0 -34.9 |
| | 100 SQ. FT. | 16.0 -32.2 |
| ZONE (2) | ROOF - EXTERIOR EDGE | |
| | 10 SQ. FT. | 16.0 -54.4 |
| | 20 SQ. FT. | 16.0 -50.9 |
| | 50 SQ. FT. | 16.0 -46.3 |
| | 100 SQ. FT. | 16.0 -42.8 |
| ZONE (3) | ROOF - EXTERIOR CORNER | |
| | 10 SQ. FT. | 16.0 -74.1 |
| | 20 SQ. FT. | 16.0 -67.1 |
| | 50 SQ. FT. | 16.0 -57.9 |
| | 100 SQ. FT. | 16.0 -50.9 |


NOTE:
ALL COMPONENTS AND CLADDING LOADS ARE ULTIMATE. FACTOR
AS REQUIRED FOR ALLOWABLE LOADING

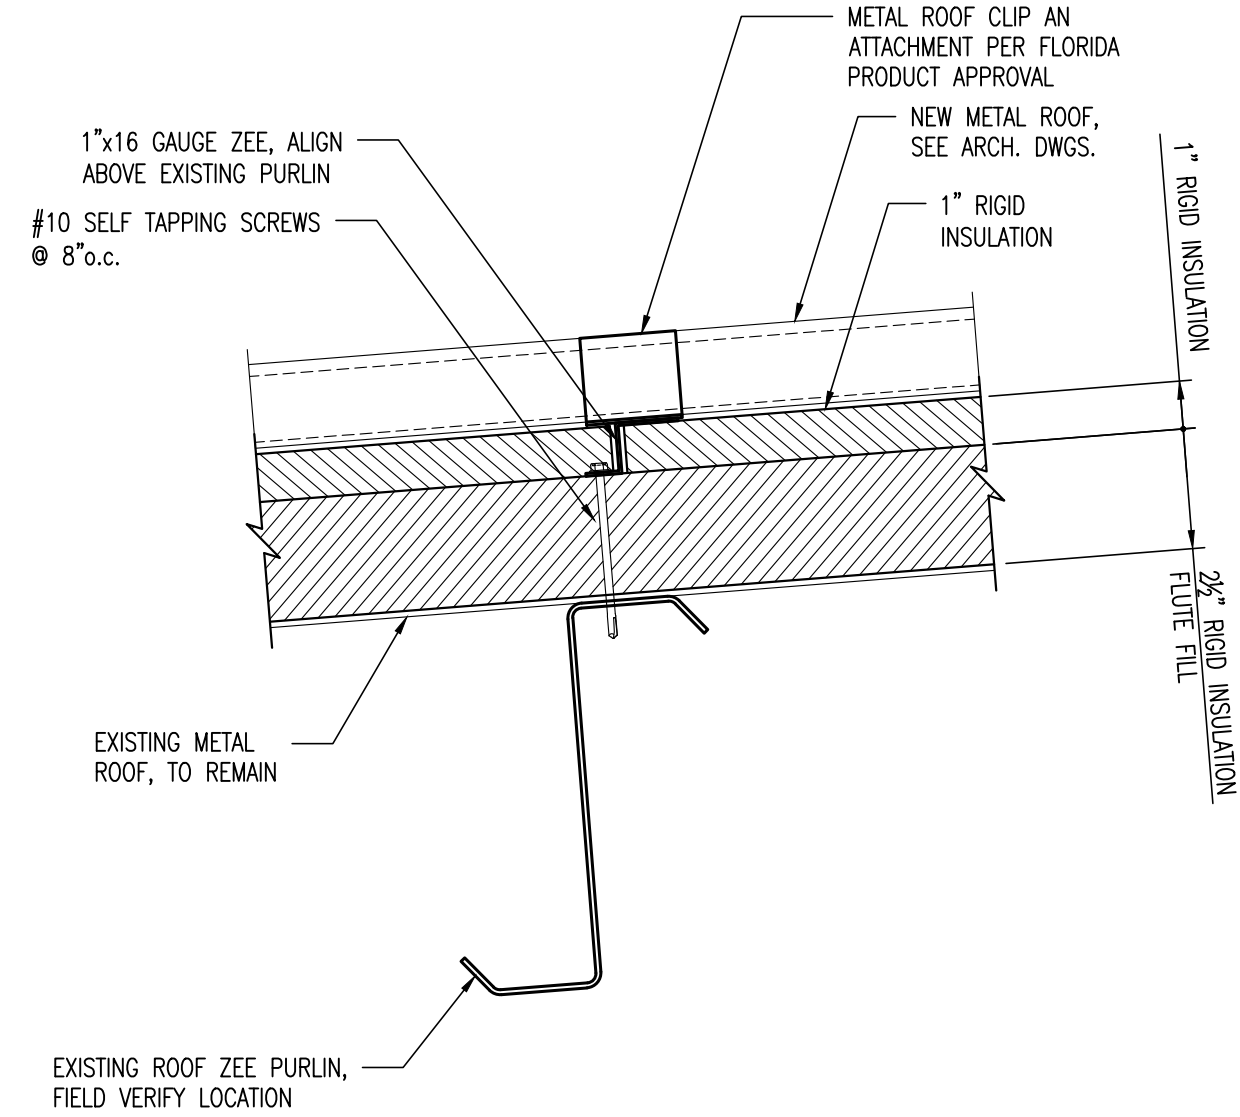

TYPICAL NEW ROOF
ATTACHMENT DETAIL
SCALE: 3/8"=1'-0"

A
S0.1

| PHASE: | DRAWN: | REVIEWED: | DATE: | ID: | REVISION: | DRAWN: | REVIEWED: | DATE: |
|--|--------|-----------|---|-----|------------|---------------------------------------|-----------|-------|
| CONCEPT SCHEM DESIGN | PHM | PHM | 10/23/24 | 1 | 02/19/2025 | | | |
| ADVANCED SCHEM DESIGN | | | | | | | | |
| 90% CONSTRUCTION DOCS | | | | | | | | |
| 100% CONSTRUCTION DOCS | | | | | | | | |
| THESE DRAWINGS AND REVISIONS ARE INSTRUMENTS OF SERVICE. THE DRAWINGS AND ASSOCIATED COPIES THEREOF, INCLUDING ELECTRONIC MEDIA AND CAD FILES, ARE THE PROPERTY OF ARCHITECTS LEWIS + WHITLOCK P.A. THEIR USE, REPRESENTATION OR REPRODUCTION FOR ANY PURPOSE EXCEPT BY WRITTEN AGREEMENT WITH THE ARCHITECT IS PROHIBITED. THIS COPYRIGHT NOTICE SHALL BE TRUE AS IF DIRECTLY PLACED ON EACH DRAWING EXHIBIT OR REVISIONS ON THIS DOCUMENT AND SHALL NOT BE REMOVED FROM THESE DOCUMENTS. | | | | | | | | |
| Client: | | | Leon County Schools Tallahassee, Florida | | | Job Title: | | |
| Consultant: | | | | | | Project #: 24510.1 | | |
| Seal: | | | | | | Phase: 100% Construction Documents | | |

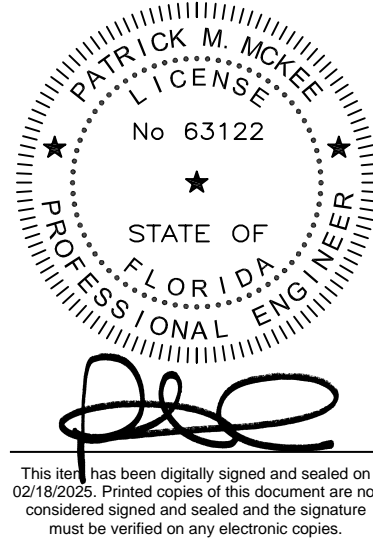

This seal has been digitally signed and sealed on 02/18/2025. Printed copies of this document are not considered signed and sealed and the signature must be verified on any electronic copies.



Description:
Structural Notes
& Details

Sheet No.:

S0.1